

Newton  
R 44  
10-9-68

MISSISSIPPI  
 BOARD OF WATER COMMISSIONERS  
 416 North State Street  
 Jackson, Mississippi 39201

WATER WELL DRILLERS LOG

**CODED**

10-9 1968 Y W Shelch Newton  
 date well completed firm name county well located

LANDOWNER: R. L. Dickerson

description of formations encountered

from to

Newton

MISS

(mailing address)

<u>Clay R</u>	<u>0</u>	<u>17</u>
<u>Blue + Shell</u>	<u>17</u>	<u>32</u>
<u>Blue</u>	<u>32</u>	<u>75</u>
<u>Blue + Sandy</u>	<u>75</u>	<u>92</u>
<u>Sand</u>	<u>92</u>	<u>134</u>

WELL LOCATION:


sec. 13 T. 6 N. R. 11 E.  
 S W  
1/2 miles N of Newton  
 (distance) (direction) (nearest town)

WELL PURPOSE: home  
 (home, irrigation, municipal, industrial)

WELL COMPLETION DATA:

- (1) diameter (inches) 2
- (2) total depth (feet) 134
- (3) static water level (feet) 41 below above top of ground.
- (4) casing steel (material), (depth) \_\_\_\_\_  
 \_\_\_\_\_ if telescope see back.  
 (size)
- (5) screen 8' (length), (depth to top) \_\_\_\_\_  
2" (size), Bronze (material)
- (6) pump 1/2 (HP), 400 (yield gpm)  
elec (type power)
- (7) electric log \_\_\_\_\_ (yes or no)  
 \_\_\_\_\_ (organization running log)
- (8) how well bottom plugged down plug


**CODED**

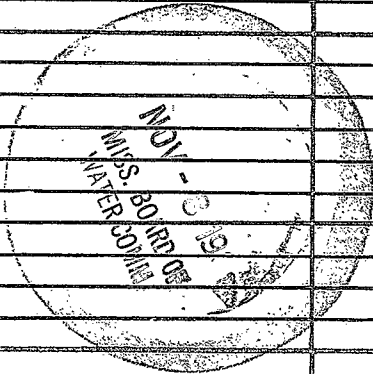

DRILLERS REMARKS:

If well telescopes please sketch and show depths.

GROUND LEVEL

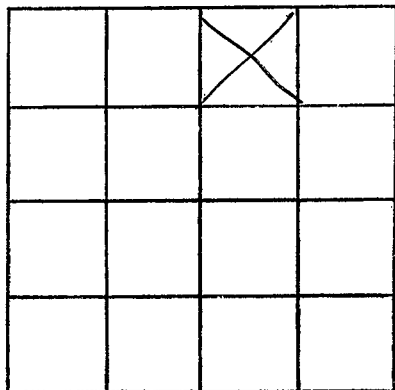

SECTION 13

Please indicate well location X.

ADDITIONAL INFORMATION

If more than one screen,  
show locations of each on sketch.