

CODED

Coded

MISSISSIPPI
 BOARD OF WATER COMMISSIONERS
 416 North State Street
 Jackson, Mississippi 39201

CODED

WATER WELL DRILLERS LOG

Newton
 R45
 11-30-68

Nov 30 1968 McDowell & Willing Newton
 date well completed firm name county well located

LANDOWNER: Victor McDowell

pt 1

Newton Miss
 (mailing address)

WELL LOCATION:

sec. 1 T 6 N R 11 E
 S W
 5 miles North of Newton
 (distance) (direction) (nearest town)

WELL PURPOSE: home
 (home, irrigation, municipal, industrial)

WELL COMPLETION DATA:

- (1) diameter (inches) 4"
- (2) total depth (feet) 360
- (3) static water level (feet) 70 below top of ground.
- (4) casing 4" 272'
 (material) (depth)
 If telescope see back.
 (size)
- (5) screen (length) (depth to top)
 (size) (material)
- (6) pump 1/2 (HP) (yield gpm)
 submersible
 (type power)
- (7) electric log (yes or no)
 (organization running log)
- (8) how well bottom plugged

description of formations encountered

from to

Clay	0	15
shell	15	40
shell & sand	40	60
sand	80	112
sand	112	142
shell	142	184
SP. rock & shell	184	210
SK. green sand	210	220
sand	220	243
Rock & Shell	243	265
Coarse sand	265	360


DEC - 4 1968

MISS. BD. OF WATER COMM.

DRILLERS REMARKS:

If well telescopes please
sketch and show depths.

GROUND LEVEL

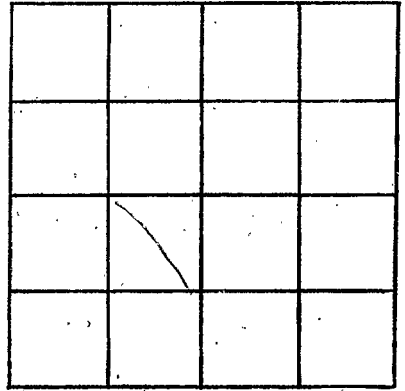

SECTION 1

Please indicate well location X.

ADDITIONAL INFORMATION

If more than one screen,
show locations of each on sketch.