

Retained 2/21/69

Newton
R 46
2-7-69

MISSISSIPPI
BOARD OF WATER COMMISSIONERS
416 North State Street
Jackson, Mississippi 39201

CODED

WATER WELL DRILLERS LOG

CODED

2-0 1969 Conroy Drilling Newton
date well completed firm name county well located

LANDOWNER: Drilled For

description of formations encountered from to

Blackburn Bros
Deaturie Miss
(mailing address)

Yellow Sand 0 20
Clay

WELL LOCATION: 2-28/69
sec 43 T. 6 N. R. 11 E.
S. W.
4 miles 5 of Deaturie
(distance) (direction) (nearest town)

Black 20 80
Dist & Bond
Ludgus 80 110

WELL PURPOSE: Home
(home, irrigation, municipal, industrial)

Sand 110 142

WELL COMPLETION DATA:

- (1) diameter (inches) 2"
- (2) total depth (feet) 152
- (3) static water level (feet) 100 below above top of ground.
- (4) casing Steel, 142,
(material) (depth)
- _____ if telescope see back.
(size)
- (5) screen 5, 142
(length) (depth to top)
- 1/4, 5/8 Johnson
(size) (material)
- (6) pump 1", 300
(HP) (yield gpm)
- _____ (type power)

(7) electric log _____
(yes or no)

_____ (organization running log)

(8) how well bottom plugged Bottom

DRILLERS REMARKS:


CODED

FEB 17 1969

MISS. BD. OF
WATER COM.

If well telescopes please sketch and show depths.

GROUND LEVEL

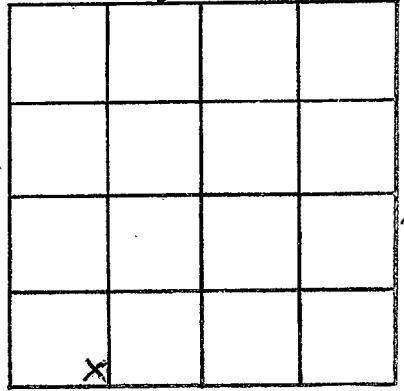

SECTION 12

Please indicate well location X.

ADDITIONAL INFORMATION

If more than one screen, show locations of each on sketch.