

Newton Co
K 47
3-69

MISSISSIPPI
BOARD OF WATER COMMISSIONERS
416 North State Street
Jackson, Mississippi 39201

CODED
CODED

WATER WELL DRILLERS LOG

March 2 1969 Wilkerson Drilling Newton
date well completed firm name county well located

LANDOWNER: ~~#~~
Mr Roy Koyendoll
Newton Miss
(mailing address)

WELL LOCATION:
sec. 28 T 6 N R 11 E
1 1/2 miles N.W. of Newton
(distance) (direction) (nearest town)

WELL PURPOSE: home
(home, irrigation, municipal, industrial)

WELL COMPLETION DATA:

- (1) diameter (inches) 2
- (2) total depth (feet) 256
- (3) static water level (feet) 60 below top of ground.
- (4) casing GALV, 252 (material), (depth)
- (5) screen 4 (length), 256 (depth to top)
- 2 (size), Stainless Steel (material)
- (6) pump 3/4 (HP), 7 (yield gpm)
- Elec (type power)
- (7) electric log NO (yes or no)

(organization running log)

(8) how well bottom plugged 2" B.W.V

description of formations encountered	from	to
Yellow Clay Sand	0	25
Sand & shale	25	80
Rock	80	85
Sand & Rock	85	98
blue clay	98	140
brown shale	140	160
Fine Sand & shale	160	205
Sand	205	240
Good Sand	240	260
Fine Sand	260	270

CODED


MAR 4 1969

MISS. BD. OF WATER COM.

DRILLERS REMARKS:

If well telescopes please sketch and show depths.

GROUND LEVEL

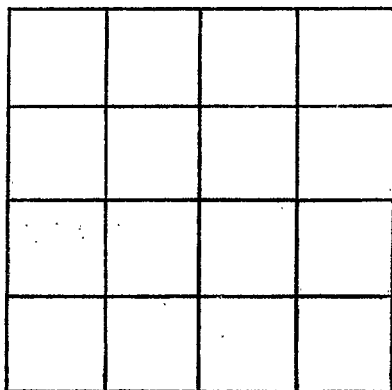

SECTION _____

Please indicate well location X.

ADDITIONAL INFORMATION

If more than one screen,
show locations of each on sketch.