

CODED

Newton
R48
4-16-69

MISSISSIPPI
BOARD OF WATER COMMISSIONERS
416 North State Street
Jackson, Mississippi 39201

CODED

WATER WELL DRILLERS LOG

4.16.69 date well completed
McDONALD & HILL firm name
NEWTON county well located

LANDOWNER: STANDARD OIL CO

NEWTON MISS

(mailing address)

WELL LOCATION:

26 sec ~~25~~ T 10 N R 11 E
S W
1 miles EAST of NEWTON
(distance) (direction) (nearest town)

WELL PURPOSE:

(home, irrigation, municipal, industrial)

WELL COMPLETION DATA:

- (1) diameter (inches) 4"
- (2) total depth (feet) 360'
- (3) static water level (feet) 49 below above top of ground.
- (4) casing Black 252 (material) (depth)
4" (size) If telescope see back.
- (5) screen (length) (depth to top)
(size) (material)
- (6) pump 1 20 (HP) (yield gpm)
220 (type power)
- (7) electric log NO (yes or no)
NO (organization running log)
- (8) how well bottom plugged OPEN

description of formations encountered

from

to

CLAY	0	20
FINE SAND	20	100
COURSE SAND	100	152
SOFT SANDY SHALE	132	162
SAND	160	195
SANDY ST SHALE	190	230
SOFT SHALE	230	245
MED SHALE	245	285
ROCK ST SHELLS	285	310
SAND	310	340
SAND	340	360

CODED


APR 28 1969

MISS. BD. OF WATER COMMISSIONERS

DRILLERS REMARKS:

If well telescopes please sketch and show depths.

GROUND LEVEL

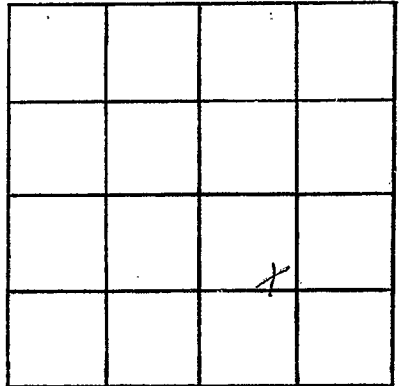

SECTION 23

Please indicate well location X.

ADDITIONAL INFORMATION

If more than one screen,
show locations of each on sketch.