

NEWTON
K 49
6-4-69

MISSISSIPPI
BOARD OF WATER COMMISSIONERS
416 North State Street
Jackson, Mississippi 39201

CODED

WATER WELL DRILLERS LOG

6-4-69 date well completed 1969 U L Shelch firm name Newton county well located

LANDOWNER: Glen Strickland
Newton
Miss
(mailing address)

description of formations encountered	from	to
Clay	0	11
S clay	11	18
Blank	18	43
Blue + shell	43	64
Blue sandy	64	107
Brown	107	128
Grey	128	171
Sandy	171	192
Gravel sand	192	203
Sand	203	229

WELL LOCATION:
sec. 25 T. 6 N. R. 11 E. S. 1 W.
1 miles (distance) E of Newton (direction) (nearest town)

WELL PURPOSE: Home
(home, irrigation, municipal, industrial)

- WELL COMPLETION DATA:
- (1) diameter (inches) 2"
 - (2) total depth (feet) 229
 - (3) static water level (feet) 42 below top of ground.
 - (4) casing 42 steel (material) (depth)
 - _____ If telescope see back. (size)
 - (5) screen 11' (length) (depth to top)
2" (size) Brass (material)
 - (6) pump 1 (HP) 450 (yield gpm)
Flaw (type power)
 - (7) electric log (yes or no)
_____ (organization running log)
 - (8) how well bottom plugged _____


JUN 23 1969

MISS. DEPT. OF
WATER CONTROL

DRILLERS REMARKS:

If well telescopes please sketch and show depths.

GROUND LEVEL

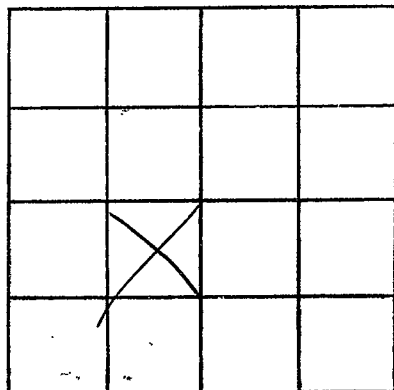

SECTION _____

Please indicate well location X.

ADDITIONAL INFORMATION

If more than one screen,
show locations of each on sketch.