

CODED

MISSISSIPPI
BOARD OF WATER COMMISSIONERS
416 North State Street
Jackson, Mississippi 39201

WATER WELL DRILLERS LOG

NEWTON
K50
5-22-69

5-22-1969 date well completed
H. L. Welch firm name
Newton county well located

LANDOWNER: S. M. Mc Ghee

description of formations encountered

from to

Newton
Miss
(mailing address)

red clay 0 20
sandy clay 20 43
sand 43 75

WELL LOCATION:

sec 20 T 6 N R 11 E
S W
2 miles NW of Newton
(distance) (direction) (nearest town)

WELL PURPOSE: home
(home, irrigation, municipal, industrial)

WELL COMPLETION DATA:

- (1) diameter (inches) 2"
- (2) total depth (feet) 75
- (3) static water level (feet) 50 below top of ground.
- (4) casing Galvalume (material) (depth)
- (size) If telescope see back.
- (5) screen 5' (length) (depth to top)
- 3" Brown (size) (material)
- (6) pump 1/2 HP 300 (yield gpm)
- Elec. (type power)
- (7) electric log (yes or no)
- (organization running log)

(8) how well bottom plugged


DRILLERS REMARKS:

JUN 23 1969

MISS. Bd. of
WATER COMMISSIONERS

If well telescopes please sketch and show depths.

GROUND LEVEL

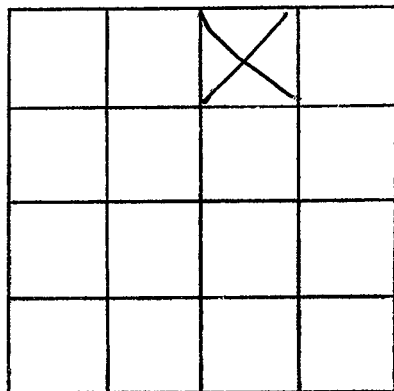

SECTION _____

Please indicate well location X.

ADDITIONAL INFORMATION

If more than one screen, show locations of each on sketch.