

CODED

Newton Co
~~FHS~~ K 51
8-69

MISSISSIPPI
BOARD OF WATER COMMISSIONERS
416 North State Street
Jackson, Mississippi 39201

WATER WELL DRILLERS LOG

8.7.1969 date well completed
McDONALD + HILL firm name
NEWTON county well located


LANDOWNER: OTIS CLARK
R#1 NEWTON
(mailing address)

| description of formations encountered | from | to |
|---------------------------------------|------|-----|
| CLAY | 0 | 8 |
| SAND ST CLAY | 8 | 45 |
| SHALE | 45 | 198 |
| SAND | 198 | 218 |

WELL LOCATION:
sec 21 T ~~X~~ N 6 R 11 E
S W
3 miles NORTH of NEWTON
(distance) (direction) (nearest town)

WELL PURPOSE: HOME
(home, irrigation, municipal, industrial)


- WELL COMPLETION DATA:
- (1) diameter (inches) 2"
 - (2) total depth (feet) 218
 - (3) static water level (feet) 100' below top of ground
 - (4) casing GALV 210' (material) (depth)
2" (size) if telescope see back.
 - (5) screen 5' 212' (length) (depth to top)
2" (size) PVC (material)
 - (6) pump 1 5 (HP) (yield gpm)
220 (type power)
 - (7) electric log NO (yes or no)
NO (organization running log)
 - (8) how well bottom plugged VALVE

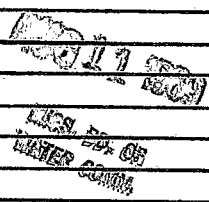

DRILLERS REMARKS:

If well telescopes please sketch and show depths.

GROUND LEVEL

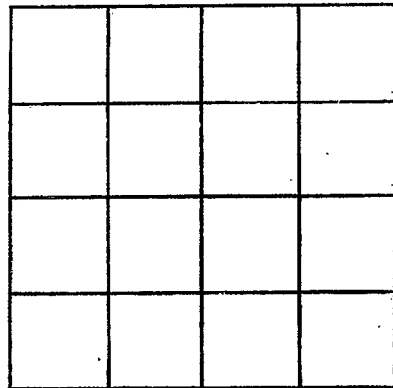

SECTION _____

Please indicate well location X.

ADDITIONAL INFORMATION

If more than one screen, show locations of each on sketch.