

CODED

MISSISSIPPI
BOARD OF WATER COMMISSIONERS
416 North State Street
Jackson, Mississippi 39201

WATER WELL DRILLERS LOG

NEWTON
K 52
1-21-70

1-21 1970 Coxens Drilling Service Newton
 date well completed firm name county well located


LANDOWNER: <u>Nathan Williams</u>	description of formations encountered	from	to
<u>R#1 Newton mini</u>			
(mailing address)	<u>50 NE</u>	<u>35</u>	<u>43</u>
WELL LOCATION: sec. <u>18</u> T. <u>6</u> N R. <u>11</u> E S W			
<u>14</u> miles <u>NW 21</u> of <u>Newton</u> (distance) (direction) (nearest town)			
WELL PURPOSE: <u>Home</u> (home, irrigation, municipal, industrial)			
WELL COMPLETION DATA:			
(1) diameter (inches) <u>2"</u>			
(2) total depth (feet) <u>42</u>			
(3) static water level (feet) <u>36</u> below above top of ground.			
(4) casing <u>Steel</u> , <u>39</u> (material) (depth) <u> </u> if telescope see back. (size)			
(5) screen <u>3</u> , <u>39</u> (length) (depth to top) <u>1 1/4</u> , <u>S/S</u> (size) (material)			
(6) pump <u> </u> , <u> </u> (HP) (yield gpm) <u> </u> (type power)			
(7) electric log <u>X</u> (yes or no) <u> </u> (organization running log)			
(8) how well bottom plugged <u>W/ku</u>			
DRILLERS REMARKS:			

FEB 16 1970

MISS. BD. OF
WATER COM.

If well telescopes please sketch and show depths.

GROUND LEVEL

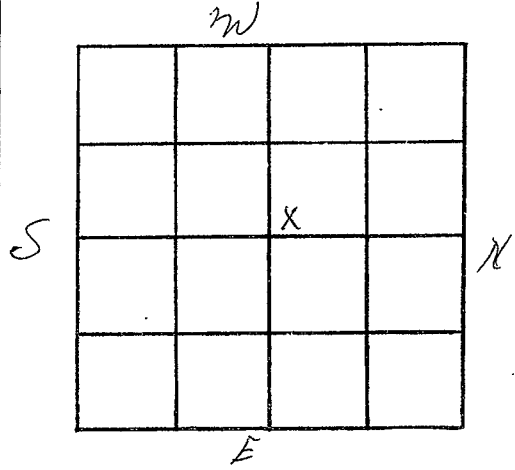

SECTION 18

Please indicate well location X.

ADDITIONAL INFORMATION

If more than one screen, show locations of each on sketch.