

NEWTON
K 53
1-27-70

MISSISSIPPI
BOARD OF WATER COMMISSIONERS
416 North State Street
Jackson, Mississippi 39201

CODED

WATER WELL DRILLERS LOG

1-27 1970 U. L. Shuler Newton
date well completed firm name county well located

LANDOWNER: Esco Corp.

description of formations encountered

from to

Newton Miss
(mailing address)

Yellow clay 0 22
Sand 22 70

WELL LOCATION:

sec 24 T. 6 N R 11 E
S W
1 miles N of Newton
(distance) (direction) (nearest town)

WELL PURPOSE:

(home, irrigation, municipal, industrial)

WELL COMPLETION DATA:

- (1) diameter (inches) 2"
- (2) total depth (feet) 70
- (3) static water level (feet) 12 below above top of ground.
- (4) casing Gal. std.
(material) (depth)
____ if telescope see back.
(size)
- (5) screen 6'
(length) (depth to top)
2" Brass
(size) (material)
- (6) pump 1 650
(HP) (yield gpm)
elec.
(type power)
- (7) electric log _____
(yes or no)

(organization running log)
- (8) how well bottom plugged _____

This is a temporary well to be used during Const by Dumas Const Co. of Birmingham Ala.


FEB 19 1970

DRILLERS REMARKS:

MISS. BD. OF
WATER COMM.

If well telescopes please sketch and show depths.

GROUND LEVEL

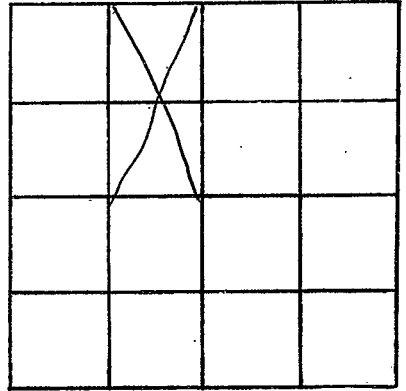

SECTION _____

Please indicate well location X.

ADDITIONAL INFORMATION

If more than one screen,
show locations of each on sketch.