

Newton  
K 54  
2-26-70

MISSISSIPPI  
BOARD OF WATER COMMISSIONERS  
416 North State Street  
Jackson, Mississippi 39201

**CODED**

WATER WELL DRILLERS LOG

Feb 26 1970 McDonald Hill Sec Newton  
date well completed firm name county well located

LANDOWNER: KATHA JONES  
Rt 1 Box 172A  
Newton Miss  
(mailing address)

description of formations encountered	from	to
Clay	0	20
shell	20	40
sandy	40	50
shell	50	62
medium sand	62	146

WELL LOCATION:  
sec 3 T. 6 N. R. 11 E  
3 miles north of Newton  
(distance) (direction) (nearest town)

WELL PURPOSE: home  
(home, irrigation, municipal, industrial)

- WELL COMPLETION DATA:
- (1) diameter (inches) 2
  - (2) total depth (feet) 146
  - (3) static water level (feet) 66 below top of ground.
  - (4) casing 2" Plastic 141  
(material) (depth)
  - no if telescope see back.  
(size)
  - (5) screen 5 141'  
(length) (depth to top)
  - 2" Plastic  
(size) (material)
  - (6) pump 1/2 10  
(HP) (yield gpm)
  - jet  
(type/power)
  - (7) electric log no  
(yes or no)
  - (organization running log)
  - (8) how well bottom plugged 2"  
back pressure valve

**CODED**


MAR 3 - 1970

MISS. Bd. of WATER COMMISSIONERS

DRILLERS REMARKS: none

If well telescopes please sketch and show depths.

GROUND LEVEL

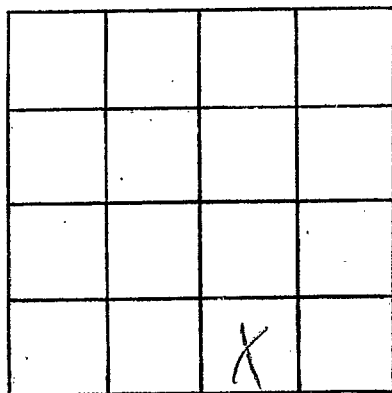

SECTION 3

Please indicate well location X.

ADDITIONAL INFORMATION

If more than one screen,  
show locations of each on sketch.