

CODED

MISSISSIPPI
BOARD OF WATER COMMISSIONERS
416 North State Street
Jackson, Mississippi 39201

WATER WELL DRILLERS LOG

NEWTON
K 55
12-2-70



Dec. 2 1970 Sony Drilling Co. Newton
date well completed firm name county well located

LANDOWNER:	description of formations encountered	from	to
(mailing address)			
<u>Esco Newton Corp</u>	<u>yellow clay</u>	<u>0</u>	<u>12</u>
<u>Newton, Miss.</u>	<u>loam</u>	<u>12</u>	<u>96</u>
	<u>clay</u>	<u>96</u>	<u>100</u>
	<u>sand</u>	<u>100</u>	<u>191</u>
	<u>clay</u>	<u>191</u>	<u>260</u>
	<u>sandy</u>	<u>260</u>	<u>300</u>
	<u>Clay to rocky</u>	<u>300</u>	<u>420</u>
	<u>fine sand</u>	<u>420</u>	<u>438</u>
	<u>Urbane sand</u>	<u>438</u>	<u>478</u>
WELL LOCATION: sec. <u>23</u> T. <u>6</u> N. R. <u>11</u> E. S. <u>1</u> <u>1/2</u> miles (distance) <u>N</u> (direction) of <u>Newton</u> (nearest town)			
WELL PURPOSE: (home, irrigation, municipal, industrial) <u>Industrial</u>			
WELL COMPLETION DATA:			
(1) diameter (inches) <u>10"</u>			
(2) total depth (feet) <u>477</u>			
(3) static water level (feet) <u>42</u> below top of ground.			
(4) casing <u>Belk</u> <u>329'</u> (material) (depth)			
<u>6"</u> (size) if telescope see back.			
(5) screen <u>40'</u> <u>431</u> (length) (depth to top)			
<u>6"</u> <u>Stainless Steel</u> (size) (material)			
(6) pump <u>20</u> <u>175</u> (HP) (yield gpm)			
<u>Submersa</u> (type power)			
(7) electric log <u>yes</u> (yes/or no) E-log # <u>24</u>			
<u>U.S.H.S</u> (organization running log)			
(8) how well bottom plugged <u>Wash shale</u>			
DRILLERS REMARKS: <u>Well yields 2 gpt</u> <u>Armed pump.</u>			

JAN 20 1971

MISS. BD. OF
WATER COM.

If well telescopes please sketch and show depths.

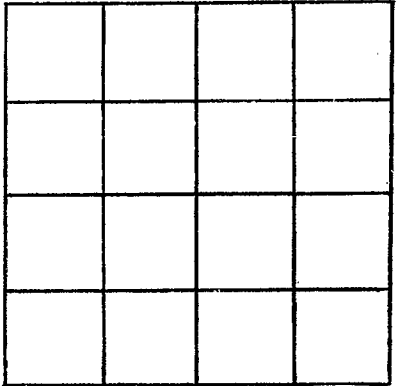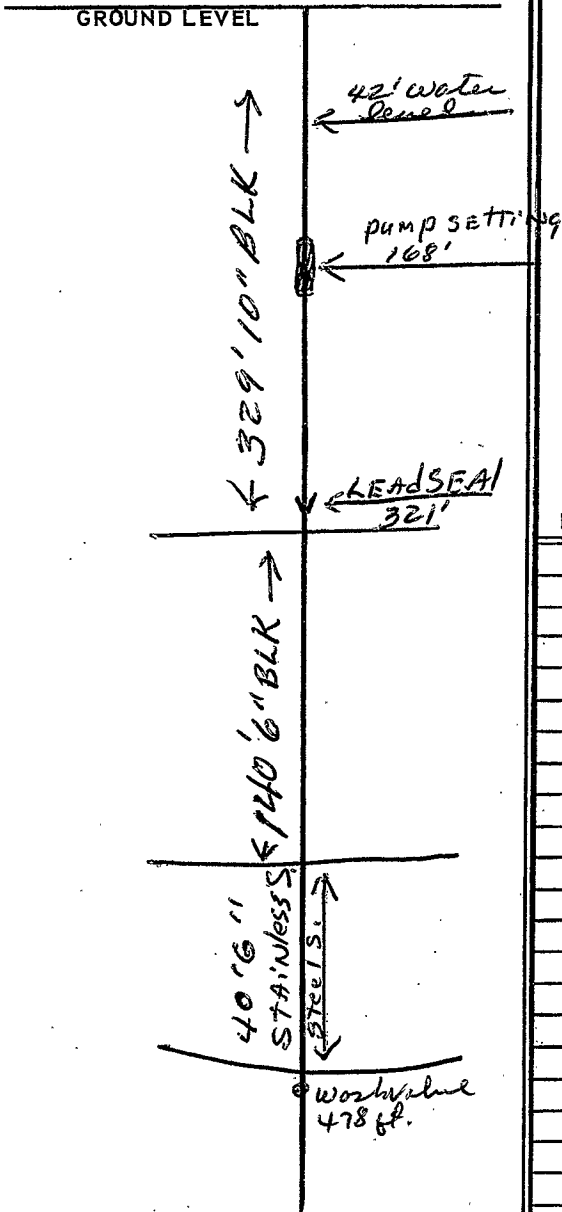

SECTION _____

Please indicate well location X.

ADDITIONAL INFORMATION

If more than one screen, show locations of each on sketch.