

Newton
K 56
3-10-70

MISSISSIPPI
 BOARD OF WATER COMMISSIONERS
 416 North State Street
 Jackson, Mississippi 39201

WATER WELL DRILLERS LOG

3-10-70 19 Thomas Reaves Newton
 date well completed firm name county well located
McDonald + Hill


LANDOWNER:	description of formations encountered	from	to
<u>Thomas Reaves</u> <u>Decatur, Miss</u> (mailing address)			
WELL LOCATION:	<u>clay</u>	<u>0</u>	<u>18</u>
sec. <u>30</u> T. <u>6</u> N. R. <u>11</u> E.	<u>shale</u>	<u>18</u>	<u>55</u>
<u>3</u> miles <u>South</u> of <u>Decatur</u>	<u>sand</u>	<u>55</u>	<u>185</u>
(distance) (direction) (nearest town)	<u>sandy</u>	<u>185</u>	<u>205</u>
WELL PURPOSE: <u>Home</u>	<u>shale</u>	<u>205</u>	<u>265</u>
(home, irrigation, municipal, industrial)	<u>sand</u>	<u>265</u>	<u>290</u>
WELL COMPLETION DATA:			
(1) diameter (inches) <u>4"</u>			
(2) total depth (feet) <u>290</u>			
(3) static water level (feet) <u>155</u> below above top of ground.			
(4) casing <u>Black</u> , <u>231</u> , (material) (depth), <u>4"</u> (size) if telescope see back.			
(5) screen _____ (length) (depth to top) (size) (material)			
(6) pump <u>34</u> <u>10</u> (HP) (yield gpm) <u>226</u> (type power)			
(7) electric log _____ (yes or no) (organization running log)			
(8) how well bottom plugged <u>OPEN</u>			
DRILLERS REMARKS:			

MAY 6 1970

MISS. BD. OF
 WATER COMM.

If well telescopes please sketch and show depths.

GROUND LEVEL

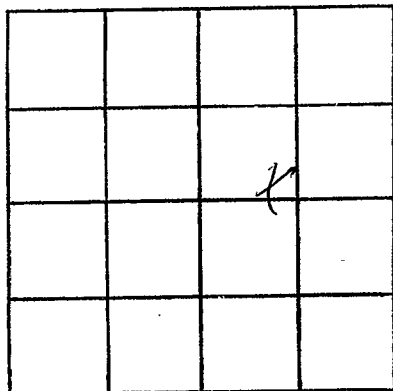

SECTION _____

Please indicate well location X.

ADDITIONAL INFORMATION

If more than one screen, show locations of each on sketch.