

Newton
K 57
5-5-70

MISSISSIPPI
 BOARD OF WATER COMMISSIONERS
 416 North State Street
 Jackson, Mississippi 39201

WATER WELL DRILLERS LOG

5-5-70 date well completed McDonald + Hill firm name NEWTON county well located

LANDOWNER: C. L. HATHAWAY
NEWTON MISS
 (mailing address)


description of formations encountered	from to	
	feet	feet
<u>CLAY</u>	<u>0</u>	<u>14</u>
<u>SANDS & CLAY</u>	<u>14</u>	<u>60</u>

WELL LOCATION:
 sec. 15 T. 6 N R. 11 E 008
3 miles WEST of NEWTON
 (distance) (direction) (nearest town)

WELL PURPOSE: HOME
 (home, irrigation, municipal, industrial)


- WELL COMPLETION DATA:
- (1) diameter (inches) 2"
 - (2) total depth (feet) 60'
 - (3) static water level (feet) 50 below top of ground.
 - (4) casing Galv 55'
 (material) (depth)
2" if telescope see back.
 (size)
 - (5) screen 5' 55'
 (length) (depth to top)
2" PVC
 (size) (material)
 - (6) pump 1/2 6
 (HP) (yield gpm)
115
 (type power)
 - (7) electric log NO
 (yes or no)
 - (organization running log)
 - (8) how well bottom plugged VALVE

DRILLERS REMARKS:

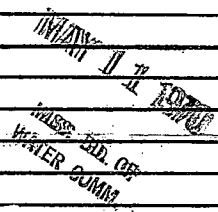

If well telescopes please sketch and show depths.

GROUND LEVEL

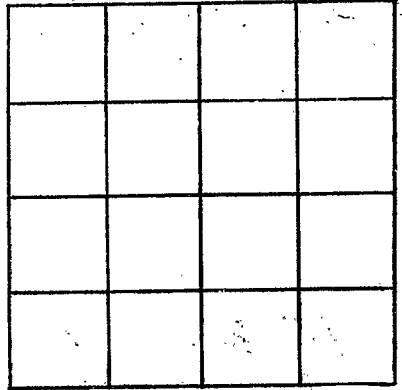

SECTION _____

Please indicate well location X.

ADDITIONAL INFORMATION

If more than one screen,
show locations of each on sketch.