

MISSISSIPPI
BOARD OF WATER COMMISSIONERS
416 North State Street
Jackson, Mississippi 39201

WATER WELL DRILLERS LOG

Newton
K 58
5-29-70
5.29.70

date well completed 19 McDonald + Hill firm name Newton county well located

LANDOWNER: BILL MAY

description of formations encountered

from to

R#1 DECATUR

Clay Sand

0 22

Shale

22 120

Sand

120 230

Shale

230 270

Rocky Shale

270 300

Green Sand

300 320

(mailing address)

WELL LOCATION:

sec. 22 T. 6 S. R. 11 E. 006

4 miles WEST of DECATUR
(distance) (direction) (nearest town)

WELL PURPOSE: HOME
(home, irrigation, municipal, industrial)

WELL COMPLETION DATA:

- (1) diameter (inches) 4-1
- (2) total depth (feet) 320
- (3) static water level (feet) 180 ~~above~~ below top of ground.
- (4) casing BLK 260'
(material) (depth)
4-1
(size) if telescope see back.
- (5) screen _____
(length) (depth to top)
(size) (material)
- (6) pump 34 10
(HP) (yield gpm)
220
(type power)
- (7) electric log NO
(yes or no)
NO
(organization running log)
- (8) how well bottom plugged OPEN


JUN 4 1970

MISS. BD. OF
WATER COMM.

DRILLERS REMARKS:

If well telescopes please sketch and show depths.

GROUND LEVEL

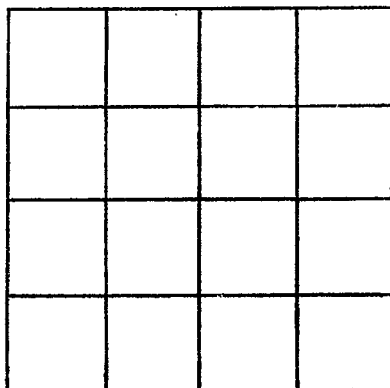

SECTION _____

Please indicate well location X.

ADDITIONAL INFORMATION

If more than one screen, show locations of each on sketch.