

Newton  
K 59  
5-8-70

MISSISSIPPI  
 BOARD OF WATER COMMISSIONERS  
 416 North State Street  
 Jackson, Mississippi 39201

WATER WELL DRILLERS LOG

5-8 1970 W.L. Welch Newton  
 date well completed firm name county well located

LANDOWNER: Robert Garvin

description of formations encountered	from	to
<u>Lawrence</u>	<u>0</u>	<u>15</u>
<u>Miss.</u>	<u>15</u>	<u>32</u>
<u>Sand</u>	<u>32</u>	<u>70</u>

Lawrence  
Miss. 39336  
 (mailing address)

WELL LOCATION: 003  
 sec. 31 T. 6 R. 11  
 S. E.

1 miles E of Lawrence  
 (distance) (direction) (nearest town)

WELL PURPOSE: Home  
 (home, irrigation, municipal, industrial)

WELL COMPLETION DATA:

- (1) diameter (inches) 2"
- (2) total depth (feet) 70
- (3) static water level (feet) 6' below above top of ground.
- (4) casing Gal Steel  
 (material) (depth)  
 \_\_\_\_\_ if telescope see back.  
 (size)
- (5) screen 6' \_\_\_\_\_  
 (length) (depth to top)  
2" \_\_\_\_\_  
 (size) (material)
- (6) pump 1 600  
 (HP) (yield gpm)  
elec  
 (type power)
- (7) electric log \_\_\_\_\_  
 (yes or no)  
 \_\_\_\_\_  
 (organization running log)
- (8) how well bottom plugged \_\_\_\_\_


DRILLERS REMARKS:

JUN 1 - 1970

MISS. BD. OF  
 WATER COMM.

If well telescopes please sketch and show depths.

GROUND LEVEL

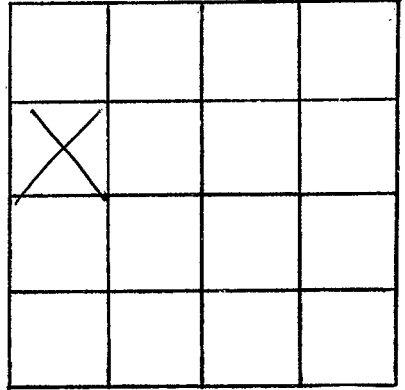

SECTION \_\_\_\_\_

Please indicate well location X.

ADDITIONAL INFORMATION

If more than one screen, show locations of each on sketch.