

MISSISSIPPI  
BOARD OF WATER COMMISSIONERS  
416 North State Street  
Jackson, Mississippi 39201

**CODED**

WATER WELL DRILLERS LOG

Newton  
K 60  
7-10-70

July 10 19 70 McDonald & Hill Inc Newton  
date well completed firm name county well located

LANDOWNER: James Gibbs

Rt 1

Newton, Miss  
(mailing address)

WELL LOCATION:

sec. 22 T. 6 N. R. 11 E.  
S. W.

5 miles West of Newton  
(distance) (direction) (nearest town)

WELL PURPOSE: home  
(home, irrigation, municipal, industrial)

WELL COMPLETION DATA:

- (1) diameter (inches) 2  
(2) total depth (feet) 159  
(3) static water level (feet) 71 below above top of ground.  
(4) casing 2" Plastic 154  
(material) (depth)

no if telescope see back.  
(size)

- (5) screen 5' 154'  
(length) (depth to top)  
2 plastic  
(size) (material)

- (6) pump 3/4 1.0  
(HP) (yield gpm)  
1/2  
(type power)

- (7) electric log no  
(yes or no)

no  
(organization running log)

- (8) how well bottom plugged 2"  
back pressure

DRILLERS REMARKS: none

description of formations encountered	from	to
Clay	0	20
Sandy with st shale	20	76
ST fine sand & shale	76	88
shale	88	100
sandy	100	110
ST fine sand & shale	110	150
coarse sand	150	159


**CODED**

JUL 15 1970

MISS. BD. OF  
WATER COMM.

If well telescopes please sketch and show depths.

GROUND LEVEL

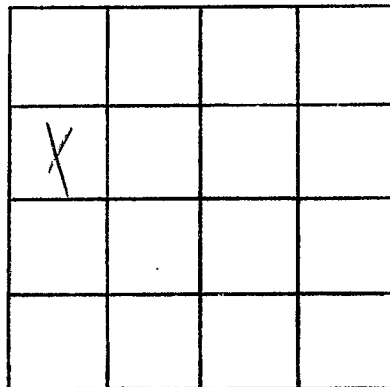

SECTION 22

Please indicate well location X.

ADDITIONAL INFORMATION

If more than one screen,  
show locations of each on sketch.