

MISSISSIPPI
BOARD OF WATER COMMISSIONER
416 North State Street
Jackson, Mississippi 39201

CODED

WATER WELL DRILLERS LOG

NEWTON
K 61
10-1-70

10-1-1970 W. L. Skelton Newton
date well completed firm name county well located

LANDOWNER: Joe Parker
Lawrence
Miss
(mailing address)

description of formations encountered	from	to
Sand clay	0	19
Blue	19	39
Blue Sand	39	59
Sand	59	90

WELL LOCATION:
sec. 19 T. 10 N. R. 11 E
3 miles NW of Newton
(distance) (direction) (nearest town)

WELL PURPOSE: Home
(home, irrigation, municipal, industrial)

WELL COMPLETION DATA:

(1) diameter (inches) 2"

(2) total depth (feet) 90

(3) static water level (feet) 36 below above top of ground.

(4) casing Gal Steel
(material) (depth)
 if telescope see back.
(size)

(5) screen 6'
(length) (depth to top)
24, Steel
(size) (material)

(6) pump 1/2 350
(HP) (yield gpm)
elec
(type power)

(7) electric log _____
(yes or no)

(organization running log)

(8) how well bottom plugged _____

CODED


OCT 30 1970

MISS. BD. OF
WATER COMM.

DRILLERS REMARKS:

If well telescopes please sketch and show depths.

GROUND LEVEL

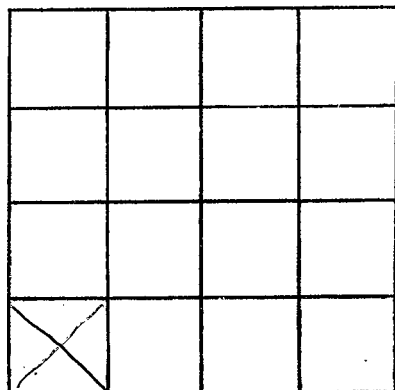

SECTION _____

Please indicate well location X.

ADDITIONAL INFORMATION

If more than one screen, show locations of each on sketch.