

MISSISSIPPI
BOARD OF WATER COMMISSIONERS
416 North State Street
Jackson, Mississippi 39201

CODED

WATER WELL DRILLERS LOG

NEWTON
K63
12-3-70

date well completed Dec 3 1970 firm name R.R. Wilkerson Drill Serv county well located Newton

LANDOWNER: Haley Evans
Newton, Miss
(mailing address)

description of formations encountered	from	to
<u>Red sand</u>	<u>0</u>	<u>20'</u>
<u>white sand</u>	<u>20</u>	<u>40</u>
<u>Water sand.</u>	<u>40'</u>	<u>67'</u>

WELL LOCATION:
sec 7 T 6 N R 11 E
6 miles West of Newton
(distance) (direction) (nearest town)

WELL PURPOSE: Home
(home, irrigation, municipal, industrial)

WELL COMPLETION DATA:

(1) diameter (inches) 2"

(2) total depth (feet) 67'

(3) static water level (feet) 26' below above top of ground.

(4) casing galv., 63'
(material) (depth)
 if telescope see back.
(size)

(5) screen 4', 63
(length) (depth to top)
2", S. Steel
(size) (material)

(6) pump 1, 3
(HP) (yield gpm)
Elec.
(type power)

(7) electric log
(yes or no)

(organization running log)

(8) how well bottom plugged B.W.V.

CODED


DEC 28 1970

DRILLERS REMARKS:

MSB. DD. OF
WELL COMING

If well telescopes please sketch and show depths.

GROUND LEVEL

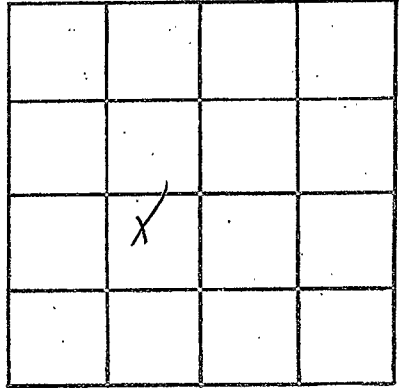

SECTION _____

Please indicate well location X.

ADDITIONAL INFORMATION

If more than one screen, show locations of each on sketch.