

Newton  
K-64  
7-5-71

MISSISSIPPI  
BOARD OF WATER COMMISSIONERS  
416 North State Street  
Jackson, Mississippi 39201

**CODED**

WATER WELL DRILLERS LOG

7-5 1971 U. L. Skelch Newton  
date well completed firm name county well located

LANDOWNER: H. McMillan  
Newton  
Miss  
(mailing address)

description of formations encountered	from	to
colony	0	29
Blue + Shell	35	60
Bray	60	80
Grey	80	100
Sand	100	120

WELL LOCATION:  
sec. 12 T 6 N R 11 E  
S W  
4 miles N of Newton  
(distance) (direction) (nearest town)

WELL PURPOSE: Home  
(home, irrigation, municipal, industrial)

- WELL COMPLETION DATA:
- (1) diameter (inches) 2"
  - (2) total depth (feet) 120
  - (3) static water level (feet) 65 below top of ground
  - (4) casing (material) HD Steel (depth) \_\_\_\_\_  
 \_\_\_\_\_ (size) If telescope see back.
  - (5) screen 6' 114  
 (length) (depth to top)  
 23' S. Steel  
 (size) (material)
  - (6) pump \_\_\_\_\_ (HP) \_\_\_\_\_ (yield gpm)  
 \_\_\_\_\_ (type power)
  - (7) electric log \_\_\_\_\_ (yes or no)  
 \_\_\_\_\_ (organization running log)
  - (8) how well bottom plugged \_\_\_\_\_

**CODED**


AUG 3 - 1971

MISS. BD. OF  
WATER COMMISSIONERS

DRILLERS REMARKS:  
Mr. McMillan plans to complete it himself

If well telescopes please sketch and show depths.

GROUND LEVEL

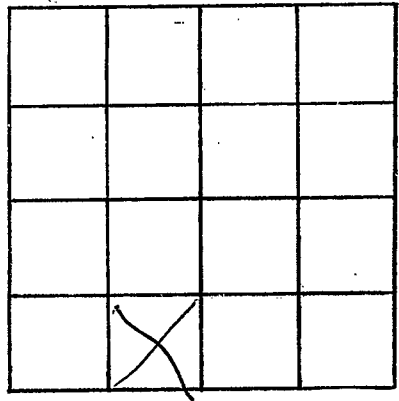

SECTION \_\_\_\_\_

Please indicate well location X.

ADDITIONAL INFORMATION

A series of horizontal lines for writing additional information.

If more than one screen, show locations of each on sketch.