

Newton
K66
2-18-72

MISSISSIPPI
 BOARD OF WATER COMMISSIONERS
 416 North State Street
 Jackson, Mississippi 39201

MAR 20 1972


WATER WELL DRILLERS LOG

2-18 1972 U. L. Welch Newton
 date well completed firm name county well located

LANDOWNER:	description of formations encountered	from	to
<u>Gene Gibbs</u>	<u>Sandy clay</u>	<u>0</u>	<u>20</u>
<u>Newton</u>	<u>Red clay</u>	<u>20</u>	<u>38</u>
<u>Miss</u>	<u>Beams</u>	<u>38</u>	<u>56</u>
(mailing address)	<u>Shells</u>	<u>56</u>	<u>100</u>
WELL LOCATION:	<u>Brown</u>	<u>100</u>	<u>170</u>
sec. <u>11</u> T. <u>6</u> S. R. <u>11</u> E.	<u>Grey</u>	<u>170</u>	<u>190</u>
<u>4</u> miles <u>N</u> of <u>Newton</u>	<u>light Brown</u>	<u>190</u>	<u>160</u>
(distance) (direction) (nearest town)	<u>Sand</u>	<u>160</u>	<u>210</u>
WELL PURPOSE: <u>Home</u>			
(home, irrigation, municipal, industrial)			
WELL COMPLETION DATA:			
(1) diameter (inches) <u>3"</u>			
(2) total depth (feet) <u>210</u>			
(3) static water level (feet) <u>100</u> below top of ground.			
(4) casing <u>Gal Steel</u> (material) (depth)			
(size) If telescope see back.			
(5) screen <u>10'</u> (length) (depth to top)			
<u>3/8" S. Steel</u> (size) (material)			
(6) pump <u>1</u> (HP) <u>600</u> (yield gpm)			
(type power)			
(7) electric log <input checked="" type="checkbox"/> (yes or no)			
(organization running log)			
(8) how well bottom plugged			
DRILLERS REMARKS:			

If well telescopes please sketch and show depths.

GROUND LEVEL

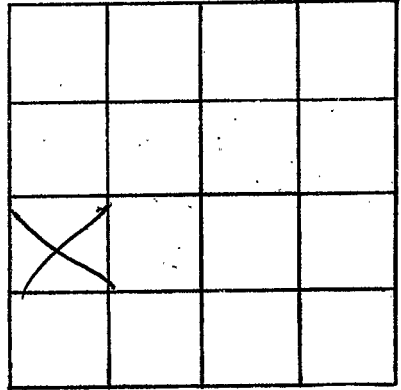

SECTION _____

Please indicate well location X.

ADDITIONAL INFORMATION

A series of horizontal lines for writing additional information, consisting of approximately 20 lines.

If more than one screen, show locations of each on sketch.