

Newton
K 67
8-3-72

MISSISSIPPI
 BOARD OF WATER COMMISSIONERS
 416 North State Street
 Jackson, Mississippi 39201

WATER WELL DRILLERS LOG

CODED

8-3 1972 W.L. Skelton Newton
 date well completed firm name county well located

LANDOWNER:
A. Hallingworth
Newton Miss
 (mailing address)

WELL LOCATION:
 sec. 22 T. 6 N. R. 11 E
1 miles N of Newton
 (distance) (direction) (nearest town)

WELL PURPOSE: Home
 (home, irrigation, municipal, industrial)

- WELL COMPLETION DATA:
- (1) diameter (inches) 3"
 - (2) total depth (feet) 392
 - (3) static water level (feet) 86 below above top of ground.
 - (4) casing Galv Steel 395'
 (material) (depth)
 - (size) If telescope see back.
 - (5) screen None
 (length) (depth to top)
 - (size) (material)
 - (6) pump 1 350 GPH
 (HP) (yield gpm)
 - (type power)
 - (7) electric log (yes or no)
 - (organization running log)
 - (8) how well bottom plugged

description of formations encountered	from	to
Sandy Clay	0	15
Clay	15	30
Bent + Shell	30	50
Brown	50	120
Brown Sandy	120	170
Sand	170	255
Pale Green	255	280
Light Brown	280	322
Shale + Rocky	322	360
Shale	360	385
Green		

CODED

AUG - 7 1972


MISS. BU. OF WATER COMMISSIONERS

DRILLERS REMARKS:

Open Hole

If well telescopes please sketch and show depths.

GROUND LEVEL

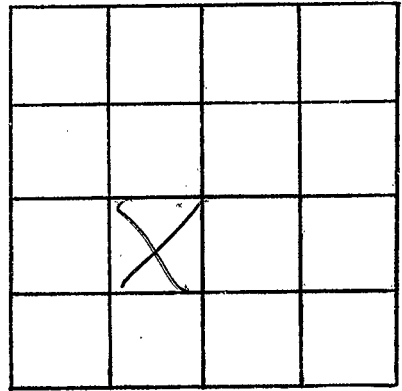

SECTION _____

Please indicate well location X.

ADDITIONAL INFORMATION

If more than one screen, show locations of each on sketch.