

Newton  
K 68  
8-11-72

MISSISSIPPI  
 BOARD OF WATER COMMISSIONERS  
 416 North State Street  
 Jackson, Mississippi 39201

**CODED**

WATER WELL DRILLERS LOG

8-11 1972 U. L. Stelich Newton  
 date well completed firm name county well located

LANDOWNER:

J. L. Wash  
Newton Miss  
 (mailing address)

description of formations encountered

from to

<u>Red Clay &amp; Silt</u>	<u>0</u>	<u>30</u>
<u>Blue</u>	<u>30</u>	<u>80</u>
<u>Blue w shale</u>	<u>80</u>	<u>120</u>
<u>Light Brown</u>	<u>120</u>	<u>160</u>
<u>Brown</u>	<u>160</u>	<u>220</u>
<u>Sand</u>	<u>220</u>	<u>350</u>
<u>Red green</u>	<u>300</u>	<u>350</u>
<u>Gray &amp; Rocky</u>	<u>350</u>	<u>375</u>
<u>Green Sch</u>	<u>375</u>	<u>400</u>

WELL LOCATION:

sec. 21 T. 4 S. R. 11 E.  
1 1/2 miles N of Newton  
 (distance) (direction) (nearest town)

WELL PURPOSE:

Home  
 (home, irrigation, municipal, industrial)

WELL COMPLETION DATA:

- (1) diameter (inches) 2"
- (2) total depth (feet) 400
- (3) static water level (feet) 174 below above top of ground
- (4) casing gal steel 303  
 (material) (depth)

\_\_\_\_\_ if telescope see back.  
 (size)

- (5) screen \_\_\_\_\_  
 (length) (depth to top)

- (6) pump 1 1/2 325  
 (HP) (yield gpm)

elec  
 (type power)

- (7) electric log \_\_\_\_\_  
 (yes or no)

\_\_\_\_\_ (organization running log)

- (8) how well bottom plugged \_\_\_\_\_

**CODED**


**AUG 15 1972**

DRILLERS REMARKS:

Open Hole

If well telescopes please sketch and show depths.

GROUND LEVEL

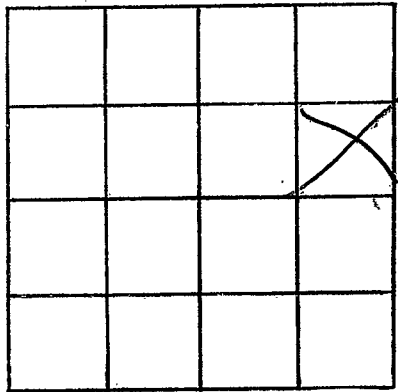

SECTION \_\_\_\_\_

Please indicate well location X.

ADDITIONAL INFORMATION

If more than one screen, show locations of each on sketch.

Handwritten scribbles and marks at the bottom right corner of the page, including a large 'X' and some illegible characters.