

**Newton**  
**K 70**  
**2-19-73**

MISSISSIPPI  
 BOARD OF WATER COMMISSIONERS  
 416 North State Street  
 Jackson, Mississippi 39201

**CODED**

**WATER WELL DRILLERS LOG**

2-19 1973 W.L. Welch Newton  
 date well completed firm name county well located


LANDOWNER:	description of formations encountered	from	to
J.H. Mendenhall Decatur Miss (mailing address)			
WELL LOCATION:	R Clay	0	20
sec. <u>7</u> T. <u>6</u> N. R. <u>11</u> E.	Sand	20	70
<u>8</u> miles <u>NW</u> of <u>Newton</u>	Blue	70	120
(distance) (direction) (nearest town)	Gray Sh. Q.	120	160
WELL PURPOSE:	Yellow	160	210
(home, irrigation, municipal, industrial)	Brown	210	250
WELL COMPLETION DATA:	Sand	250	335
(1) diameter (inches) <u>4 x 7</u>	Brown	335	380
(2) total depth (feet) <u>465</u>	Shell	380	390
(3) static water level (feet) <u>165</u> below top of ground.	<del>Shell</del>		
(4) casing <u>PVC</u> (material) (depth)	Brown	380	400
(size) if telescope see back.	Grayish B.	400	445
(5) screen <u>None Open Hole</u> (length) (depth to top)	Green Sand	445	460
(size) (material)			
(6) pump <u>1</u> (HP) <u>700</u> (yield gpm)			
(type power)			
(7) electric log <u>No</u> (yes or no)			
(organization running log)			
(8) how well bottom plugged			
DRILLERS REMARKS:			

**CODED**


DATE  
 MAR 12 1973

If well telescopes please sketch and show depths.

GROUND LEVEL

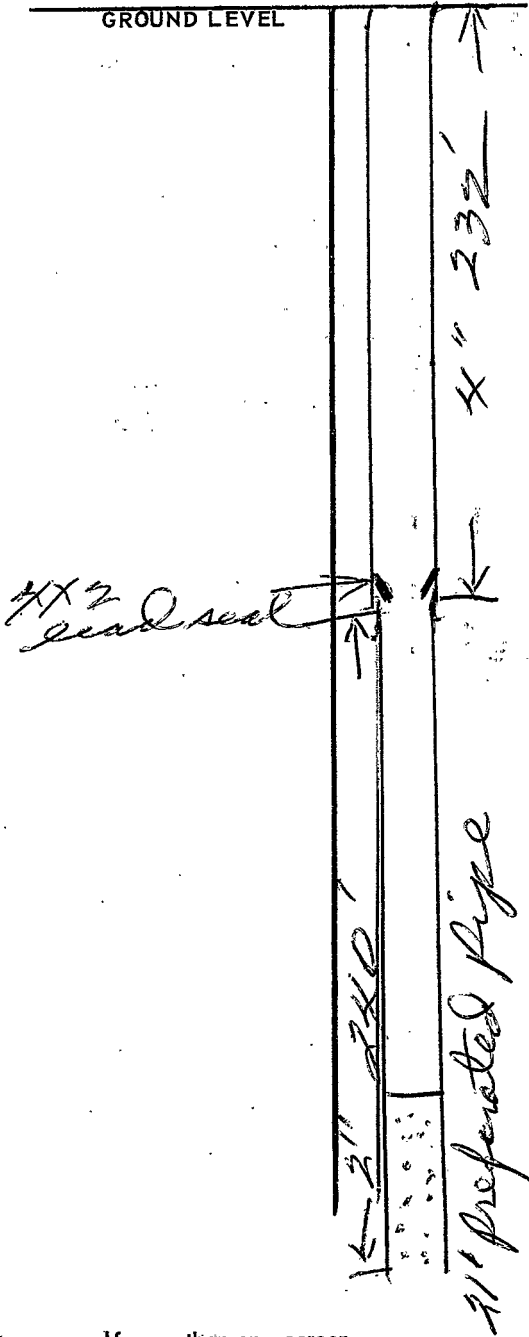

If more than one screen, show locations of each on sketch.

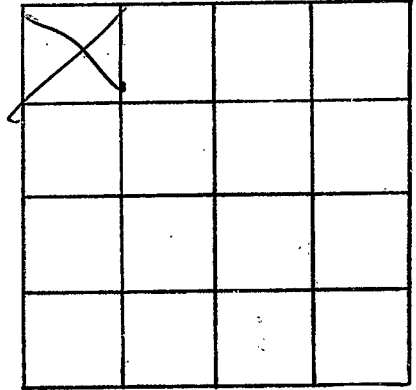

SECTION \_\_\_\_\_

Please indicate well location X.

ADDITIONAL INFORMATION

Lined area for additional information.