

MISSISSIPPI
BOARD OF WATER COMMISSIONERS
416 North State Street
Jackson, Mississippi 39201

CODED

Newton
K 71
3-7-73

WATER WELL DRILLERS LOG

3.7.73
date well completed

McDONALD + HILL
firm name

NEWTON
county well located

LANDOWNER:

John Lee Doss

description of formations encountered

from to

NEWTON

(mailing address)

WELL LOCATION:

sec. 36 T 6 N R 11 E

miles of (distance) (direction) (nearest town)

WELL PURPOSE:

HOME (home, irrigation, municipal, industrial)

WELL COMPLETION DATA:

- (1) diameter (inches) 4 1/2
- (2) total depth (feet) 420'
- (3) static water level (feet) 115' below above top of ground.
- (4) casing PVC 320' (material) (depth)
4" (size) if telescope see back.
- (5) screen (length) (depth to top)
(size) (material)
- (6) pump 1/2 (HP) 10 (yield gpm)
220 (type power)
- (7) electric log (yes or no)
(organization running log)
- (8) how well bottom plugged OPEN

description of formations encountered	from	to
Clay	0	20
Shale	20	40
Sandy	40	100
Shale	100	90
Sand	90	235
Soft Shale	235	250
Sand	250	290
Soft Shale	290	310
Shale	310	390
Sand to Rock	390	420


CODED

DRILLERS REMARKS:

WELL 1271473

If well telescopes please
sketch and show depths.

GROUND LEVEL

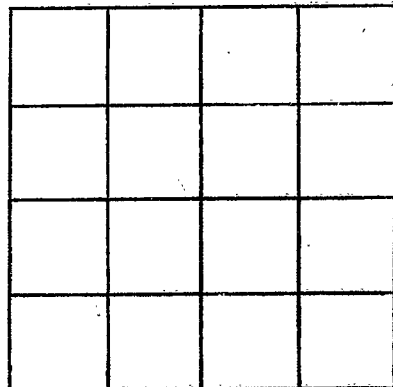

SECTION _____

Please indicate well location X.

ADDITIONAL INFORMATION

If more than one screen,
show locations of each on sketch.