

NEWTON
K 73
7-23-73

MISSISSIPPI
BOARD OF WATER COMMISSIONERS
416 North State Street
Jackson, Mississippi 39201

CODED

WATER WELL DRILLERS LOG

6-22 1973 W.L. Kolsh Newton
date well completed firm name county well located

LANDOWNER:
J.B. Jauge
Newton, Miss
(mailing address)

WELL LOCATION:
sec 31 T 6 N R 11 E
2 miles NW of Newton
(distance) (direction) (nearest town)

WELL PURPOSE:
Home
(home, irrigation, municipal, industrial)

- WELL COMPLETION DATA:
- (1) diameter (inches) 3"
 - (2) total depth (feet) 400
 - (3) static water level (feet) 96 below above top of ground.
 - (4) casing Gal. Steel
(material) (depth)
 - (size) if telescope see back.
 - (5) screen Open hole
(length) (depth to top)
 - (size) (material)
 - (6) pump 1 350
(HP) (yield gpm)
 - elec
(type power)
 - (7) electric log no
(yes or no)
 - (organization running log)
 - (8) how well bottom plugged


description of formations encountered	from	to
Red clay	0	30
Sand	30	40
Blue	40	100
Shale	100	120
Grey	120	154
Bro CODED	154	200
Washed sand	200	220
Sand	220	300
Blocks	300	350
rocky	350	375
Shale Sand	375	400

APR 30 1973

DRILLERS REMARKS:
I am out of log book
Please send one

If well telescopes please sketch and show depths.

GROUND LEVEL

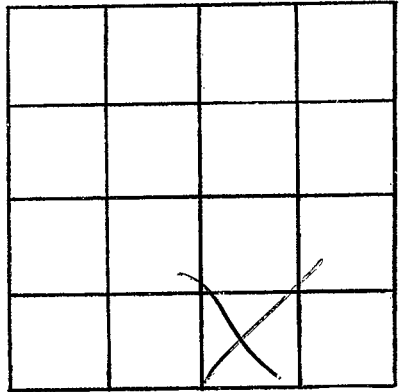

SECTION _____

Please indicate well location X.

ADDITIONAL INFORMATION

If more than one screen,
show locations of each on sketch.