

NEWTON  
K 74  
7-23-73

MISSISSIPPI  
 BOARD OF WATER COMMISSIONERS  
 416 North State Street  
 Jackson, Mississippi 39201

CODED

WATER WELL DRILLERS LOG

6-21-73 date well completed      73 Wilkerson Drilling firm name      Newton county well located

LANDOWNER: Mr Floyd McGehee

description of formations encountered

from to

Red clay	0	10
SAND	10	25
Yellow clay	25	40
Brown	40	100
Sand	100	200

Newton Miss  
 (mailing address)

WELL LOCATION:

sec 21 T 6 N R 11 E  
 S W

2 miles N.W. of Newton  
 (distance) (direction) (nearest town)

WELL PURPOSE: home  
 (home, irrigation, municipal, industrial)

WELL COMPLETION DATA:

- (1) diameter (inches) 2
- (2) total depth (feet) 209
- (3) static water level (feet) 70 below above top of ground.
- (4) casing PVC, 204,  
 (material) (depth)

         if telescope see back.  
(size)

- (5) screen 5, 204  
 (length) (depth to top)
- 2", 5 Steel  
 (size) (material)

- (6) pump 1, 7  
 (HP) (yield gpm)

Elec. Jet.  
(type power)

- (7) electric log NO  
 (yes or no)

          
(organization running log)


- (8) how well bottom plugged 2" Rad

DRILLERS REMARKS:

JUL 10 1973

If well telescopes please sketch and show depths.

GROUND LEVEL

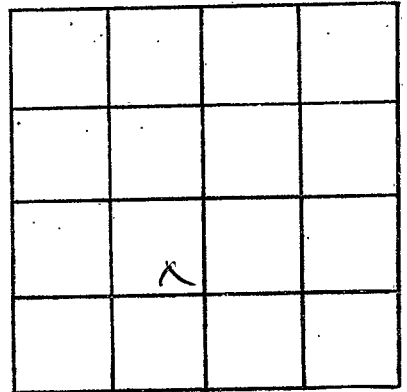

SECTION 21

Please indicate well location X.

ADDITIONAL INFORMATION

If more than one screen,  
show locations of each on sketch.