

**NEWTON**  
**K 76**  
**8-30-73**

MISSISSIPPI  
 BOARD OF WATER COMMISSIONERS  
 416 North State Street  
 Jackson, Mississippi 39201  
**CODED**  
**WATER WELL DRILLERS LOG**

8, 30-73 19 MCDONALD + HILL NEWTON  
 date well completed firm name county well located

**LANDOWNER:**  
Billy BARRETT  
R# 5 UNION  
 (mailing address)

description of fomations encountered	from	to
<u>CLAY</u>	<u>0</u>	<u>12</u>
<u>SAND</u>	<u>12</u>	<u>60</u>

**WELL LOCATION:**  
 sec. 26 T. 6 N. R. 11 E.  
1 miles NORTH of STRATTON  
 (distance) (direction) (nearest town)

**WELL PURPOSE:** LEAD  
 (home, irrigation, municipal, industrial)

**WELL COMPLETION DATA:**

(1) diameter (inches) 2"

(2) total depth (feet) 60'

(3) static water level (feet) 22' below top of ground. above

(4) casing PVC 53'  
 (material) (depth)  
2"  
 (size) if telescope see back.

(5) screen 5' 55'  
 (length) (depth to top)  
2" PVC  
 (size) (material)

(6) pump 3/4 JET 10  
 (HP) (yield gpm)  
ELECTRIC  
 (type power)

(7) electric log \_\_\_\_\_  
 (yes or no)  
 \_\_\_\_\_  
 (organization running log)

(8) how well bottom plugged VALVE

**CODED**


SEP 6 1973

**DRILLERS REMARKS:**

MISSISSIPPI BOARD OF WATER COMMISSIONERS

If well telescopes please sketch and show depths.

GROUND LEVEL

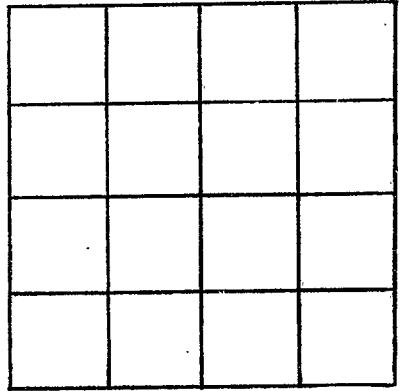

SECTION \_\_\_\_\_

Please indicate well location X.

ADDITIONAL INFORMATION

If more than one screen, show locations of each on sketch.