

NEWTON
K 77
3-22-74

MISSISSIPPI
BOARD OF WATER COMMISSIONERS
416 North State Street
Jackson, Mississippi 39201

CODED

WATER WELL DRILLERS LOG

3, 22, 74
date well completed

McDONALD + HILL
firm name

NEWTON
county well located

LANDOWNER:

MRS BERNICE McMOLLEN

RE/ NEWTON MISS
(mailing address)

WELL LOCATION:

sec. 11 T 6 N R 11 E
4 miles NORTH of NEWTON
(distance) (direction) (nearest town)

WELL PURPOSE: NONE
(home, irrigation, municipal, industrial)

WELL COMPLETION DATA:

- (1) diameter (inches) 4"
- (2) total depth (feet) 350'
- (3) static water level (feet) 170' below top of ground.
- (4) casing PVC 284' (material) (depth)
4" (size) if telescope see back.
- (5) screen (length) (depth to top)
(size) (material)
- (6) pump OWN (HP) (yield gpm)
(type power)
- (7) electric log (yes or no)
(organization running log)
- (8) how well bottom plugged *dm*

description of formations encountered

from to

Clay	0	10
Sand	10	40
SHALE	40	140
SAND	140	260
SAND	260	272
SHALE	272	312
ROCK	312	320
GREEN SAND	320	350

CODED


RECORDED
MAR 27 1974

DRILLERS REMARKS:

MISS. BD. OF WATER COMMISSIONERS

If well telescopes please sketch and show depths.

GROUND LEVEL

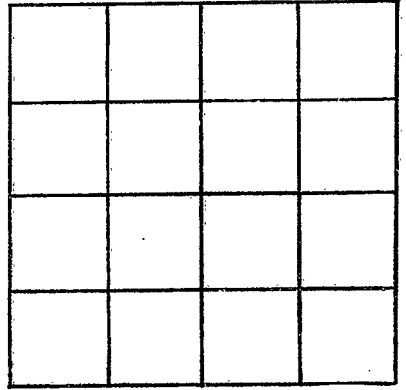

SECTION _____

Please indicate well location X.

ADDITIONAL INFORMATION

If more than one screen, show locations of each on sketch.