

NEWTON

K 79

4-1-74

MISSISSIPPI BOARD OF WATER COMMISSIONERS  
416 North State Street  
Jackson, Mississippi 39201

CODED

WATER WELL DRILLERS LOG

4-1  
date well completed

1974 U. L. Welch  
firm name

Newton  
county well located

LANDOWNER: F. Cornbert

description of formations encountered

from to

Newton

Relay Sand

0 20

Miss

Brown

20 60

(mailing address)

Shy

60 78

WELL LOCATION:

sec. 20 T. 6N N R. 11 E  
S W  
5 miles NE of Newton  
(distance) (direction) (nearest town)

Sandy

78 120

WELL PURPOSE: Home  
(home, irrigation, municipal, industrial)

Sand

120 154

WELL COMPLETION DATA:

- (1) diameter (inches) 2"
- (2) total depth (feet) 154
- (3) static water level (feet) 40 below top of ground
- (4) casing 1/2" steel (material), (depth)

CODED

(size) If telescope see back.

- (5) screen 5' (length), (depth to top)  
2 1/2" 5" steel (size) (material)

- (6) pump 1 (HP), 300 (yield gpm)  
elec (type power)

- (7) electric log 310 (yes or no)

(organization running log)

- (8) how well bottom plugged

DRILLERS REMARKS:


RECORDED

APR 28 1974

MISS. BD. OF WATER COMMISSIONERS

If well telescopes please sketch and show depths.

GROUND LEVEL

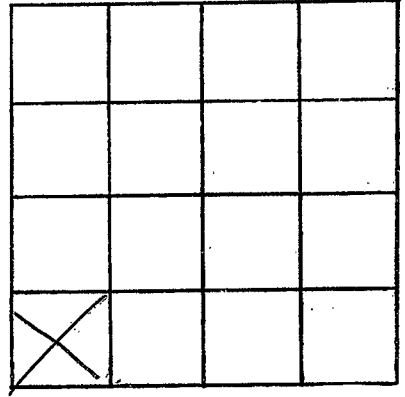

SECTION \_\_\_\_\_

Please indicate well location X.

ADDITIONAL INFORMATION

If more than one screen,  
show locations of each on sketch.