

NEWTON

K 80

8-9-74

MISSISSIPPI
 BOARD OF WATER COMMISSIONERS
 416 North State Street
 Jackson, Mississippi 39201

WATER WELL DRILLERS LOG

8-9-74
date well completed

McDONALD & HILL
firm name

NEWTON
county well located

LANDOWNER:

CHESTER Willys
NEWTON
(mailing address)

description of formations encountered

from

to

Clay lt sand

0

20

Shale

20

80

Sand lt shale

80

90

Shale

90

170

Sand

170

270

Sand shale

270

370

Shale

370

360

Sand lt shale

360

420

WELL LOCATION:

sec. 10 T. 6 N. R. 11 E.
3 miles NORTH of NEWTON
(distance) (direction) (nearest town)

WELL PURPOSE:

HOME
(home irrigation, municipal, industrial)

WELL COMPLETION DATA:

- (1) diameter (inches) 4"
- (2) total depth (feet) 420'
- (3) static water level (feet) 170' below top of ground.
- (4) casing PVC 3 1/8"
(material) (depth)
4"
(size) if telescope see back.
- (5) screen _____
(length) (depth to top)
(size) (material)
- (6) pump 1 sub 6
(HP) (yield gpm)
ELECTRIC
(type power)
- (7) electric log _____
(yes or no)
(organization running log)
- (8) how well bottom plugged OPEN

CODED


RECEIVED
AUG 13 1974

MISS. BD. OF WATER COMM

DRILLERS REMARKS:

If well telescopes please sketch and show depths.

GROUND LEVEL

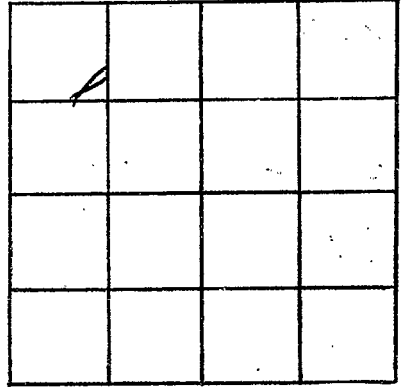

SECTION _____

Please indicate well location X.

ADDITIONAL INFORMATION

If more than one screen,
show locations of each on sketch.