

NEWTON

K 82

10-30-79

MISSISSIPPI BOARD OF WATER COMMISSIONERS
416 North State Street
Jackson, Mississippi 39201

WATER WELL DRILLERS LOG

10-30 date well completed
1979 U. L. Welch firm name
Newton county well located

LANDOWNER:

C. Armstrong

description of formations encountered

from to

Newton

Reday

0 18

Smith (mailing address)

WELL LOCATION:

sec 20 T 4 N R 11 E

4 miles NW of Newton (distance) (direction) (nearest town)

Sand

18 62

WELL PURPOSE:

(home, irrigation, municipal, industrial)

WELL COMPLETION DATA:

- (1) diameter (inches) 2 1/2
- (2) total depth (feet) 62
- (3) static water level (feet) 42 below top of ground.
- (4) casing PVC (material), (depth) if telescope see back.
- (5) screen 5 (length), (depth to top) 1 1/2 (size), PVC (material)
- (6) pump 1/2 (HP), 300 (yield gpm), elec (type power)
- (7) electric log (yes or no)
- (organization running log)
- (8) how well bottom plugged

CODED


DRILLERS REMARKS:

RECEIVED NOV 19 1979

MISSISSIPPI BOARD OF WATER COMMISSIONERS

If well telescopes please
 sketch and show depths.

GROUND LEVEL

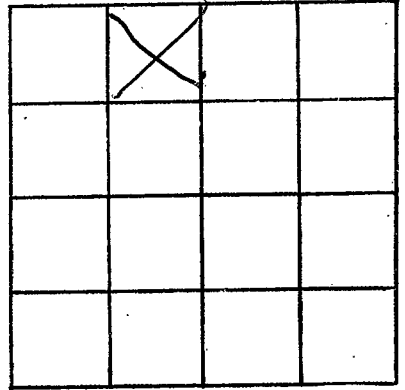

SECTION _____

Please indicate well location X.

ADDITIONAL INFORMATION

If more than one screen,
 show locations of each on sketch.