

MISSISSIPPI
BOARD OF WATER COMMISSIONERS
416 North State Street
Jackson, Mississippi 39201

CODED

WATER WELL DRILLERS LOG

NEWTON
K83
11/25/74

11-25-74
date well completed

McDONALD + MILL
firm name

NEWTON
county well located

LANDOWNER:

J.S. PARKER

(mailing address)

WELL LOCATION:

sec. 30 T. 6 N. R. 11 E.
5 miles WEST of STRATTON
(distance) (direction) (nearest town)

WELL PURPOSE:

14 ORME
(home, irrigation, municipal, industrial)

WELL COMPLETION DATA:


- (1) diameter (inches) 4"
- (2) total depth (feet) 280'
- (3) static water level (feet) 195' below top of ground.
- (4) casing PVC, 200' (material) (depth)
4" (size) if telescope see back.
- (5) screen (length) (depth to top)
(size) (material)
- (6) pump 1 sub 10 (HP) (yield gpm)
ELECTRIC (type power)
- (7) electric log (yes or no)
(organization running log)
- (8) how well bottom plugged OPEN

description of formations encountered

from to

CLAY	0	20
SAND + ST CLAY	20	160
SOFT SHALE	160	170
SANDY	170	180
MED SHALE	180	205
SHALE WITH SAND ST	205	230
ROCK ST SHALE SAND	230	260
GREEN SAND	260	280

CODED

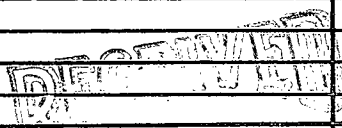


NOV 23 1974

DRILLERS REMARKS:

MISS. Bd. OF WATER COMMISSIONERS

If well telescopes please sketch and show depths.

GROUND LEVEL

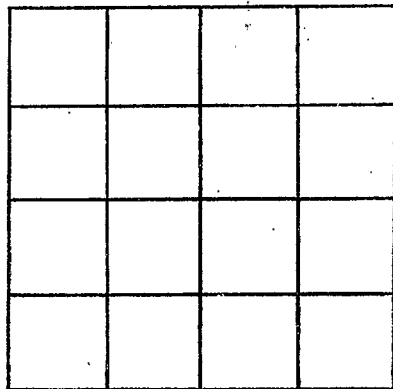

SECTION _____

Please indicate well location X.

ADDITIONAL INFORMATION

If more than one screen,
show locations of each on sketch.