

NEWTON
K 84
12-11-74

MISSISSIPPI
 BOARD OF WATER COMMISSIONERS
 416 North State Street
 Jackson, Mississippi 39201

CODED
 +

WATER WELL DRILLERS LOG

12-11-74 19 McDONALD + HILL NEWTON
 date well completed firm name county well located

LANDOWNER:
DOROTHY SCHACHTE
R#1 NEWTON
 (mailing address)

WELL LOCATION:
 sec 20 T 6 N R 11 E
3 1/2 miles N WEST of NEWTON
 (distance) (direction) (nearest town)

WELL PURPOSE: HOME
 (home, irrigation, municipal, industrial)

WELL COMPLETION DATA:

(1) diameter (inches): 4"

(2) total depth (feet): 435'

(3) static water level (feet): 135' below above top of ground.

(4) casing: PVC 352'
 (material) (depth)
4"
 (size) if telescope see back.

(5) screen _____
 (length) (depth to top)
 (size) (material)

(6) pump 1/2 sub 10
 (HP) (yield gpm)
ELECTRIC
 (type power)

(7) electric log _____
 (yes or no)
 (organization running log)

(8) how well bottom plugged OPEN

description of formations encountered	from	to
CLAY	0	10
SAND ST CLAY	10	44
SHALE	44	152
BROWN SHALE	152	210
BROWN SAND	210	305
SOFT SAND	305	340
SHALE	340	380
ROCK ST SAND	380	420
GREEN SAND	420	435


DRILLERS REMARKS:

RECEIVED
 DEC 18 1974

MISS. BD OF WATER

If well telescopes please sketch and show depths.

GROUND LEVEL

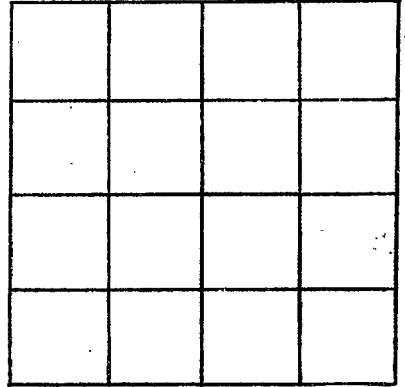

SECTION _____

Please indicate well location X.

ADDITIONAL INFORMATION

If more than one screen,
show locations of each on sketch.