

NEWTON
K 85
12-12-74

MISSISSIPPI
BOARD OF WATER COMMISSIONERS CODED
416 North State Street
Jackson, Mississippi 39201

WATER WELL DRILLERS LOG

12-12-74 date well completed
McDONALD + HILL firm name
NEWTON county well located

LANDOWNER: MRS ELLEN GILL
R#2 DECATUR (mailing address)
WELL LOCATION: sec. 19 T. 6 N. R. 11 E. 3 miles WEST of STRATTON (distance) (direction) (nearest town)

WELL PURPOSE: HOME (home) Irrigation, municipal, industrial

WELL COMPLETION DATA:
(1) diameter (inches) 4"
(2) total depth (feet) 275'
(3) static water level (feet) 130' below top of ground.
(4) casing PVC 202' (material) (depth) 4" (size) if telescope see back.
(5) screen (length) (depth to top) (size) (material)
(6) pump 1/2 sub 6 (HP) (yield gpm) ELECTRIC (type power)
(7) electric log (yes or no)
(organization running log)
(8) how well bottom plugged OPEN

description of formations encountered	from	to
CLAY	0	22
SAND + CLAY	22	120
SAND	120	160
SOFT SHALE	160	185
ROCK ST SHALE	185	190
SHALE	190	228
ROCK ST SHALE	228	240
CODED SAND ST SHALE	240	275


REGISTERED
DEC 16 1974

DRILLERS REMARKS:

MISS. BD. OF WATER COMMISSIONERS

If well telescopes please sketch and show depths.

GROUND LEVEL

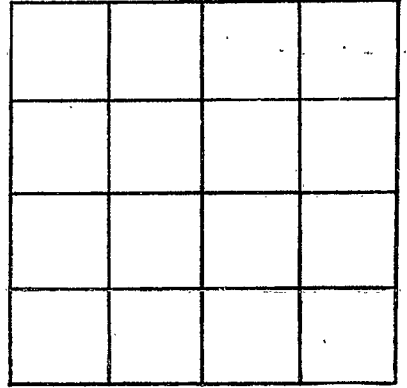

SECTION _____

Please indicate well location X.

ADDITIONAL INFORMATION

If more than one screen,
show locations of each on sketch.