

NEWTON
K 86
4-9-75

MISSISSIPPI
 BOARD OF WATER COMMISSIONERS
 416 North State Street
 Jackson, Mississippi 39201

CODED

WATER WELL DRILLERS LOG

4-9 1975 W.K. Shelton⁰⁰³ Newton
 date well completed firm name county well located

LANDOWNER: JIM WASH
Newton
Miss
 (mailing address)

description of formations encountered	from	to
	0	18
	18	43

WELL LOCATION:
 sec. 21 T. 6 N. R. 11 E.
2 miles NW of Newton
 (distance) (direction) (nearest town)

WELL PURPOSE: None
 (home, irrigation, municipal, industrial)

WELL COMPLETION DATA:

- (1) diameter (inches) 2"
- (2) total depth (feet) 43
- (3) static water level (feet) 22 below top of ground.
- (4) casing PVC (material), (depth)
 _____ if telescope see back.
 (size)
- (5) screen 5' (length), (depth to top)
2" (size), PVC (material)
- (6) pump 1 (HP), 300 (yield gpm)
elec (type power)
- (7) electric log yes (yes or no)
 _____ (organization running log)
- (8) how well bottom plugged _____

RECEIVED
 RECEIVED


MAY - 8 1975

DRILLERS REMARKS: _____

MISS. BD. OF WATER COMMISSIONERS

If well telescopes please sketch and show depths.

GROUND LEVEL

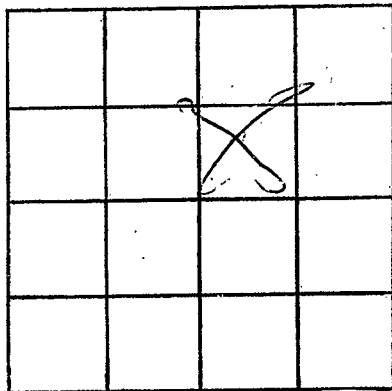

SECTION _____

Please indicate well location X.

ADDITIONAL INFORMATION

If more than one screen, show locations of each on sketch.