

NEWTON

K 88

5-28-75

MISSISSIPPI BOARD OF WATER COMMISSIONERS 416 North State Street Jackson, Mississippi 39201

WATER WELL DRILLERS LOG

CODED

5-28

1975

J. L. Welch

Newton

date well completed

firm name

county well located

LANDOWNER:

Jack Brand

description of formations encountered

from

to

Newton

R Clay

0 4

Miss

Dark Brown

40

(mailing address)

WELL LOCATION:

sec. 8 T. 6 N

R. 11 E

4 miles (distance)

NW of Newton (direction) (nearest town)

Blue

40 50

Blue + Gray

50 100

Brown Gray 100 140

Gray Sand 140 160

WELL PURPOSE:

Camp (home, irrigation, municipal, industrial)

WELL COMPLETION DATA:

- (1) diameter (inches) 2 1/2
(2) total depth (feet) 240
(3) static water level (feet) 92 below top of ground.
(4) casing PVC (material), (depth)

Sandy 160 200

Sand 200 240

CODED

If telescope see back. (size)

- (5) screen 5' (length), (depth to top)

- (6) pump 1 (HP), 3.50 (yield gpm)

- (7) electric log (yes or no)

(organization running log)


- (8) how well bottom plugged

DRILLERS REMARKS:

DEPARTMENT OF WATER CONTROL JUN 4 1975 MISS. BOARD OF WATER COMMISSIONERS

If well telescopes please sketch and show depths.

GROUND LEVEL

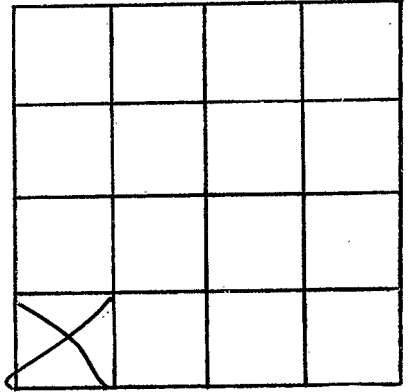

SECTION _____

Please indicate well location X.

ADDITIONAL INFORMATION

If more than one screen, show locations of each on sketch.