

Newton
K 89
9-30-75

MISSISSIPPI
 BOARD OF WATER COMMISSIONERS
 416 North State Street
 Jackson, Mississippi 39201

CODED

WATER WELL DRILLERS LOG

9-30-75 19 McDonald + M Newton
 date well completed firm name county well located

LANDOWNER: LOZENA KING
PO BOX NEWTON MISS
 (mailing address)

WELL LOCATION:
 sec. 8 T. 6 N. R. 11 E. 13P
4 miles NORTH of NEWTON
 (distance) (direction) (nearest town)

WELL PURPOSE:
 (home, irrigation, municipal, industrial)

WELL COMPLETION DATA:

(1) diameter (inches) 11"
 (2) total depth (feet) 380'
 (3) static water level (feet) 112' below top of ground.
 (4) casing 2 1/2" (material) 3 1/2" (depth)
11" If telescope see back. (size)
 (5) screen (length) (depth to top)
 (size) (material)
 (6) pump 2 1/2" sub L (HP) (yield gpm)
 (type power)
 (7) electric log (yes or no)
 (organization running log)
 (8) how well bottom plugged OPEN

description of formations encountered	from	to
<u>Clay sand</u>	<u>0</u>	<u>30</u>
<u>shale</u>	<u>30</u>	<u>175</u>
<u>sand</u>	<u>175</u>	<u>280</u>
<u>shale Limestone</u>	<u>280</u>	<u>320</u>
<u>sandy</u>	<u>320</u>	<u>340</u>
<u>shale</u>	<u>340</u>	<u>370</u>
<u>rock shell</u>	<u>370</u>	<u>380</u>
<u>sand</u>	<u>380</u>	<u>385</u>


CODED

MISS. Bd. OF WATER COMMISSIONERS
 OCT - 6 1975
 MISS. Bd. OF WATER COMMISSIONERS

DRILLERS REMARKS:
SET PUMP 220'

If well telescopes please sketch and show depths.

GROUND LEVEL

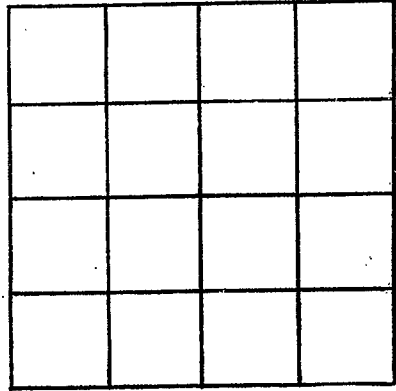

SECTION _____

Please indicate well location X.

ADDITIONAL INFORMATION

If more than one screen, show locations of each on sketch.