

NEWTON

K 90

10-2-75

MISSISSIPPI BOARD OF WATER COMMISSIONERS
416 North State Street
Jackson, Mississippi 39201

CODED

WATER WELL DRILLERS LOG

10-3 1975 W.L. Stalch Newton
date well completed firm name county well located

LANDOWNER: W.A. BARNETT

Newton Miss

(mailing address)

WELL LOCATION:

sec. 35 T. 4 N. R. 10 E. ^{13p}
in City Limit
(distance) (direction) (nearest town)

WELL PURPOSE: Drinking
(home, irrigation, municipal, industrial)

WELL COMPLETION DATA:

- (1) diameter (inches) 4x2
- (2) total depth (feet) 281
- (3) static water level (feet) 87 below top of ground.
- (4) casing Steel pipe
(material) (depth)
- 4x2 if telescope see back.
(size)
- (5) screen 10' (length) (depth to top)
2 1/2" S. Steel
(size) (material)
- (6) pump 1 (HP) 1200 (yield gpm)

(type power)

(7) electric log (yes or no)

(organization running log)

(8) how well bottom plugged

DRILLERS REMARKS:

description of formations encountered

from

to

R clay

0 16

Sand

16 30

Blue

30 60

Blue shale

60 90

Grey

90 140

Brown

140 195

Shay

195 210

Sand

210 281

RECEIVED
OCT - 7 1975
MISS. Bd. OF WATER COMMISSIONERS

If well telescopes please sketch and show depths.

GROUND LEVEL

Water level 87' →

11' 89'


4x2 lead seal

Back Wash Valve

501 105

181 105

Strainers

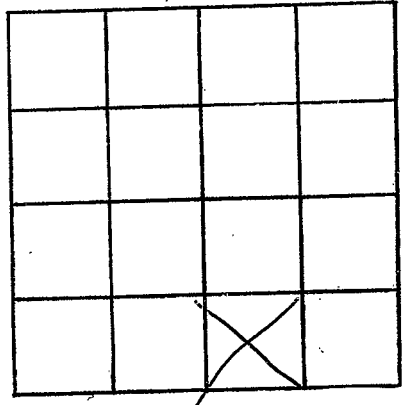

SECTION _____

Please indicate well location X.

ADDITIONAL INFORMATION

If more than one screen, show locations of each on sketch.