

MISSISSIPPI DEPARTMENT OF NATURAL RESOURCES

Bureau of Land and Water Resources

Southport Mall

CODED

P.O. Box 10631

Jackson, Mississippi 39209

WATER WELL DRILLERS LOG

K93  
 NEWTON CO.  
 3/85

3 1985 McDonald's Wellcare Newton  
 date well completed firm name county well located

LANDOWNER: N Richardson  
 R#1 Box 234  
 Newton Miss 39345  
 (mailing address)

Description of formations encountered	from	to
Clay & sand	0	25
shale	25	90
shale st sand	90	140
shale sandy st	140	180
shale	180	220
green sand st rock	220	245
coarse green sand	245	257

WELL LOCATION:  
 sec. 1 T. 6 R. 11  
 3 1/2 miles north of Newton  
 (distance) (direction) (nearest town)

WELL PURPOSE: home  
 (home, irrigation, municipal, industrial)



- WELL COMPLETION DATA:
- (1) diameter (inches) 4
  - (2) total depth (feet) 257
  - (3) static water level (feet) 115 below top of ground.
  - (4) casing 4" PVC 207' (material) (depth)  
 41' 2" PVC (size) If telescope see back.
  - (5) screen 15' (length) (depth to top)  
 2" PVC #12 (size) (material)
  - (6) pump (HP) (yield gpm)  
 (type power)
  - (7) electric log (yes or no)
  - (8) how well bottom plugged 1-2" back pressure valve

DRILLERS REMARKS:  
 1-482" Rubber seal

RECEIVED  
 MAR 15 1985  
 Department of Natural Resources  
 Bureau of Land & Water Resources

If well telescopes please sketch and show depths.

GROUND LEVEL

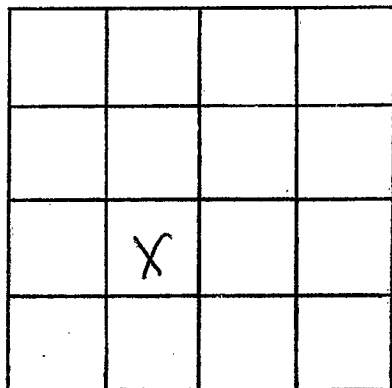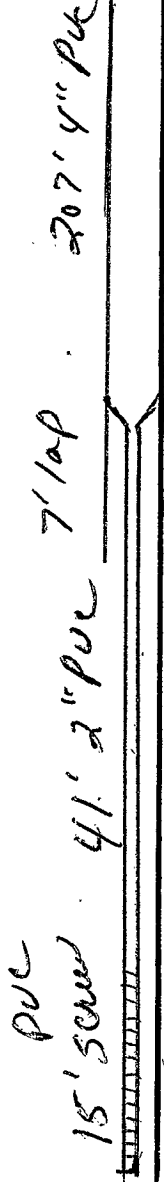

SECTION 1

Please indicate well location X.

ADDITIONAL INFORMATION

If more than one screen,  
show locations of each on sketch.