
	State Well Report	
County: Newton	Part 1	For Office Use Only:
Permit #:	fississippi Department of Environmental Quality	Aquifer:
Driller ME EON ACE + the	Office of Land and Water Resources P.O. Box 10631	Well #: K-102
	Jackson, MS 39289-0631	L. S. Elevation:
Date drilling completed: 6 - 0	(601)961-5210	
	(601)354-6938 (fax)	E-log #:
State Law requires that this report 30 days of completion of drilling of	be prepared by the driller in detail and filed w the well.	ith the Department within
Well Owner Information	****	Location
Owner Name 70000 M	Latitude: 32 • 19 . 37	" Longitude: <u>\$1°C7.59</u> "
Mailing Address: U5 - SILN	Method of Lat/Long (circle on	e): Conventional Survey,
100 01	USGS quad, Hand-held	GPS, Survey-grade GPS
City State	M 3932 7 SW 4 SW 4 Sec 25	Twn 76N Rng IE
Telephone No. 431-446-03	• • • • • • • • • • • • • • • • • • • •	of Natest Town
	Well Data	
Purpose of Well (circle one) Home Industr	ial Public Supply Irrigation Fish Culture	Other:
Date well drilling started:	Date well drilling completed: 6	A
·		<i>y- 0 &</i>
If flowing, method of flow regulation: Valve_		•
Static Water Level: 140 feet above	or below (circle one) land surface Date measured:	
	tape electric tape air line other:	KING
Hole depth: 197 Well depth:	10.7	/O feet
Type of grout (circle one): Cement B	entonite Mix	
101	iameter:inches Type of casing:	RC
Screen length:feet		Pic
m A S	Setting depth: From 177 feet to 19	7 feet
Type of completion (circle all applicable): Gr	, , , , , , , , , , , , , , , , , , , ,	
o	ther (describe):	
Top of lap pipe or reduction in casing:		en, describe on back of page
Logs run (circle all applicable) No log run	Rectric Gamma Ray Density Sonic Neutron C	
Name of organization running log(s):		
certuy that the well was drilled, constructed	d, and completed in accordance with all applicable re	equirements of the Mississippi
Department of Environmental Quality and/or	r the Mississippi Department of Health regulations a	nd state laws.
NECOURLE + Hel, I	Nc. # 0-8 Han	d the
Print Name of Water Well Contractor and Licer	ise No.	RECEIVED

If well telescopes please sketch below and show depths.

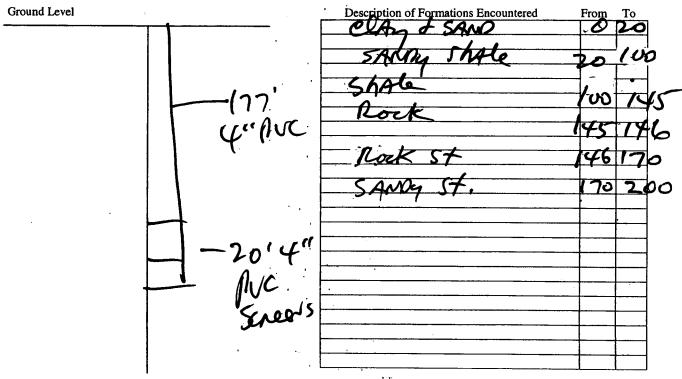

If more than one screen, show location of each on sketch

Sketch the property layout and include the following: 1) the well location; 2) any permanent structures on the property that may aid in locating the well; 3) any roads, power lines, or other items that may aid in locating the property and the well; 4) indicate direction.	
back of rel	
Landowner Name: Freddy Ma Deich	

Signature of Water Well Contractor

RECEIVED

JUN 2 3 2006

BY: OLWR

	STATE WE	ELL REPORT		
County: Wewsh Permit #: Driller: NEOnall + H Date completed: 6-6-06	Part 2 Pump Installer's Completion Report Mississippi Department of Environmental Quality Office of Land and Water Resources P.O. Box 10631 Jackson, MS 39289-0631 (601)961-5210 (601)354-6938 (fax)			, , , , , , , , , , , , , , , , , , ,
This report should be prepared by th installation of pump.		l and filed with the Dep	partment within 30 da	ys of the
Owner Name: Well Owner Information Owner Name: Well Owner Information Owner Information Owner Information Owner Name: Well Owner Information Owner Informati	meneral ce nf	Method of Lat/Long (c	Well Location Longitude: ircle one): Convention Hand-held GPS, Sun	al Survey,
City State	MS_39327 Zip Code -0518	Distance Dire	Sec 25 Twn T6	Mng 11E
Telephone No. (15) 476			Not Kec	Alu
D T				
Pump Type Circle one			Power Type Circle one	
	Submersible	Diesel Engine		Natural Gas
Circle one	Submersible Turbine	Diesel Engine Electric Motor	Circle one	Natural Gas Tractor PTO
Circle one Air Lift Jet			Circle one Gasoline Engine	· · · · · · · · · · · · · · · · · · ·
Circle one Air Lift Jet Bucket Piston	Turbine	Electric Motor Windmill	Circle one Gasoline Engine Hand Other (specify):	· · · · · · · · · · · · · · · · · · ·
Circle one Air Lift Jet Bucket Piston Centrifugal Rotary	Turbine	Electric Motor Windmill Horse Power Rating of	Circle one Gasoline Engine Hand Other (specify):	· · · · · · · · · · · · · · · · · · ·
Circle one Air Lift Jet Bucket Piston Centrifugal Rotary Other (specify):	Turbine	Electric Motor Windmill	Circle one Gasoline Engine Hand Other (specify): Motor: 3/4	Tractor PTO
Circle one Air Lift Bucket Piston Centrifugal Rotary Other (specify): Date Pump Installed: Rated Pump Capacity:	Turbine Flowing Well	Electric Motor Windmill Horse Power Rating of Setting Depth: Number of Stages:	Circle one Gasoline Engine Hand Other (specify): Motor: 190	Tractor PTO
Circle one Air Lift Jet Bucket Piston Centrifugal Rotary Other (specify):	Turbine Flowing Well Ob Gallons Per Minute	Electric Motor Windmill Horse Power Rating of Setting Depth: Number of Stages:	Circle one Gasoline Engine Hand Other (specify): Motor: 3/4	Tractor PTO
Circle one Air Lift Bucket Piston Centrifugal Rotary Other (specify): Date Pump Installed: Rated Pump Capacity: Pump Test Data Date Well Tested:	Turbine Flowing Well Ob Gallons Per Minute	Electric Motor Windmill Horse Power Rating of Setting Depth: Number of Stages: Method Air Line Electric	Circle one Gasoline Engine Hand Other (specify): Motor: 190 14	Tractor PTO
Circle one Air Lift Bucket Piston Centrifugal Rotary Other (specify): Date Pump Installed: Rated Pump Capacity: Pump Test Data Date Well Tested: Static Water Level (A): A STATE Piston Rotary Feet	Turbine Flowing Well O6 Gallons Per Minute	Electric Motor Windmill Horse Power Rating of Setting Depth: Number of Stages: Method	Circle one Gasoline Engine Hand Other (specify): Motor: 190 14 of Measuring Water Circle one	Tractor PTO feet Level
Circle one Air Lift Jet Bucket Piston Centrifugal Rotary Other (specify): Date Pump Installed: Rated Pump Capacity: Pump Test Data Date Well Tested: Static Water Level (A): Pumping Water Level (B): Feet F	Turbine Flowing Well O6 Gallons Per Minute O6 Below Land Surface	Electric Motor Windmill Horse Power Rating of Setting Depth: Number of Stages: Method Air Line Electric	Circle one Gasoline Engine Hand Other (specify): Motor: 190 14 of Measuring Water Circle one ic Measuring Line	Tractor PTO feet Level

Frint Name of Fump Installer and License No. (if applicable) Signature of Pump Installer
--

Duration of Pump Test (minimum 4 hours): _