

NEWTON
K 2001
9-16-76

MISSISSIPPI
BOARD OF WATER COMMISSIONERS
416 North State Street
Jackson, Mississippi 39201

13P

WATER WELL DRILLERS LOG

9-16-76 date well completed 19 McDonald + Hill firm name NEWTON county well located

LANDOWNER: PURVIS REECE
R#1 NEWTON MISS (mailing address)
WELL LOCATION: sec 3 T 60 N R 11 E 4 miles N WEST NEWTON (distance) (direction) (nearest town)
WELL PURPOSE: (home, irrigation, municipal, industrial)
WELL COMPLETION DATA:

description of formations encountered	from	to
Clay Sand	0	26
Clay	26	120
Shale	120	145
Sand	145	250
Soft sandy shale	250	278
Shale	278	317
Shale bit Rock	317	340
Sand bit Shale	340	380

- (1) diameter (inches) 4"
- (2) total depth (feet) 380'
- (3) static water level (feet) 163 below top of ground.
- (4) casing PVC 290' (material) (depth) 4" (size) if telescope see back.
- (5) screen (length) (depth to top) (size) (material)
- (6) pump 24 Sub 6 (HP) (yield gpm) E (type power)
- (7) electric log (yes or no) (organization running log)
- (8) how well bottom plugged OPEN


RECEIVED
SEP 20 1976

MISS. BD. OF WATER COMMISSIONERS

DRILLERS REMARKS:

If well telescopes please sketch and show depths.

GROUND LEVEL

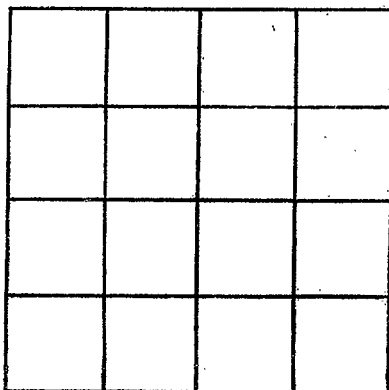

SECTION _____

Please indicate well location X.

ADDITIONAL INFORMATION

If more than one screen, show locations of each on sketch.