

**NEWTON**  
**K 2003**  
**1-22-77**

MISSISSIPPI  
 BOARD OF WATER COMMISSIONERS  
 416 North State Street  
 Jackson, Mississippi 39201

WATER WELL DRILLERS LOG

1-22-77 1977 Williamson Drilling Newton  
 date well completed firm name county well located

LANDOWNER: Elli. J. Shaw  
Box 371 Docton Miss.  
 (mailing address)

WELL LOCATION:  
 sec. 1 T 6N R 11E  
3 1/2 miles south of Docton  
 (distance) (direction) (nearest town)

WELL PURPOSE: Home  
 (home, irrigation, municipal, industrial)

- WELL COMPLETION DATA:
- (1) diameter (inches) 4
  - (2) total depth (feet) 377
  - (3) static water level (feet) 80 below above top of ground.
  - (4) casing NIP 150  
 (material) (depth)  
1 1/2 if telescope see back.  
 (size)
  - (5) screen na  
 (length) (depth to top)  
 (size) (material)
  - (6) pump 1 1/2 12  
 (HP) (yield gpm)  
Elect.  
 (type power)
  - (7) electric log na  
 (yes or no)  
na  
 (organization running log)
  - (8) how well bottom plugged open

| description of formations encountered | from | to  |
|---------------------------------------|------|-----|
| top soil                              | 0    | 3   |
| blue clay                             | 3    | 42  |
| sand                                  | 42   | 170 |
| sand & clay                           | 70   | 185 |
| blue clay                             | 185  | 260 |
| red clay                              | 260  | 304 |
| blue clay                             | 304  | 348 |
| sand                                  | 348  | 377 |


**RECEIVED**  
 MAY 2 - 1977

DRILLERS REMARKS:

MISSISSIPPI BOARD OF WATER COMMISSIONERS

If well telescopes please sketch and show depths.

GROUND LEVEL

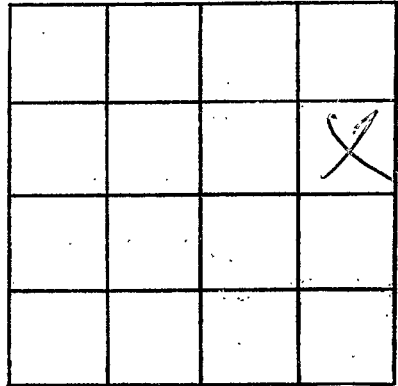

SECTION 1

Please indicate well location X.

ADDITIONAL INFORMATION

If more than one screen, show locations of each on sketch.