

NEWTON
K 2004
1-31-77

MISSISSIPPI
 BOARD OF WATER COMMISSIONERS
 416 North State Street
 Jackson, Mississippi 39201

WATER WELL DRILLERS LOG

1-31-77
 date well completed

McDonald + Hill
 firm name

Newton
 county well located

LANDOWNER:
Ora Dee Lewis
Rt #1 Newton
 (mailing address)

description of formations encountered	from	to
<u>Clay + sand</u>	<u>0</u>	<u>30</u>
<u>shale</u>	<u>30</u>	<u>55</u>
<u>sandy shale, st shell</u>	<u>55</u>	<u>90</u>
<u>shale</u>	<u>90</u>	<u>110</u>
<u>sandy st shell</u>	<u>110</u>	<u>120</u>
<u>Brown shale</u>	<u>120</u>	<u>190</u>
<u>shale st sand</u>	<u>190</u>	<u>200</u>
<u>sand</u>	<u>200</u>	<u>210</u>

WELL LOCATION:
 sec. 21 T 6 N R. 11 E
3 miles N of Newton
 (distance) (direction) (nearest town)

WELL PURPOSE: Home
 (home, irrigation, municipal, industrial)

- WELL COMPLETION DATA:
- (1) diameter (inches) 2"
 - (2) total depth (feet) 210'
 - (3) static water level (feet) 96' below above top of ground.
 - (4) casing PVC, 105'
 (material) (depth)
21"
 (size) if telescope see back.
 - (5) screen 5', 705#110
 (length) (depth to top)
2", PVC
 (size) (material)
 - (6) pump 1, 59 gpm
 (HP) (yield gpm)
E
 (type power)
 - (7) electric log
 (yes or no)

 (organization running log)
 - (8) how well bottom plugged water


RECEIVED
 FEB 8 1977

MISS. BD. OF WATER COMMISSIONERS

DRILLERS REMARKS:

If well telescopes please sketch and show depths.

GROUND LEVEL

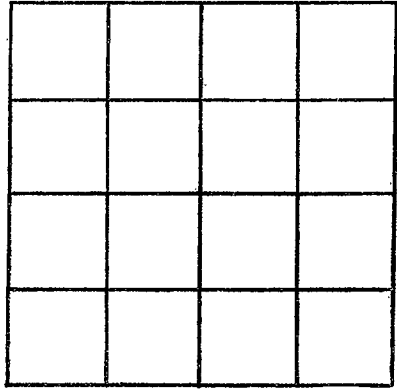

SECTION _____

Please indicate well location X.

ADDITIONAL INFORMATION

If more than one screen,
show locations of each on sketch.