

**MISSISSIPPI
BOARD OF WATER COMMISSIONERS**
416 North State Street
Jackson, Mississippi 39201

WATER WELL DRILLERS LOG

Newton
K 2005
2/25/77

13P


2-25-77 19 McDonald + Hill Newton
date well completed firm name county well located

LANDOWNER:	description of formations encountered	from	to
<u>Carlton Little</u> <u>Rt #1 Newton</u> (mailing address)			
WELL LOCATION: sec. <u>22</u> T. <u>6</u> N. R. <u>11</u> E <u>2</u> miles <u>N</u> of <u>Newton</u> (distance) (direction) (nearest town)	<u>shale</u>	<u>10</u>	<u>35</u>
WELL PURPOSE: <u>home</u> (home, irrigation, municipal, industrial)	<u>shale + sand</u>	<u>35</u>	<u>100</u>
WELL COMPLETION DATA:	<u>sand</u>	<u>100</u>	<u>210</u>
(1) diameter (inches) <u>4"</u>	<u>sandy shale</u>	<u>210</u>	<u>290</u>
(2) total depth (feet) <u>350'</u>	<u>shale</u>	<u>250</u>	<u>288</u>
(3) static water level (feet) <u>67'</u> below above top of ground.	<u>Rock + shell</u>	<u>288</u>	<u>315</u>
(4) casing <u>PVC 280</u> (material) (depth) <u>4"</u> (size) If telescope see back.	<u>green, sand</u>	<u>315</u>	<u>350</u>
(5) screen _____ (length) (depth to top) (size) (material)			
(6) pump <u>1/2</u> <u>5000</u> (HP) (yld gpm) <u>F</u> (type power)			
(7) electric log _____ (yes or no) (organization running log)			
(8) how well bottom plugged <u>Open</u>			
DRILLERS REMARKS:			

RECEIVED
MAR - 7 1977
MISC. EN.

If well telescopes please sketch and show depths.

GROUND LEVEL

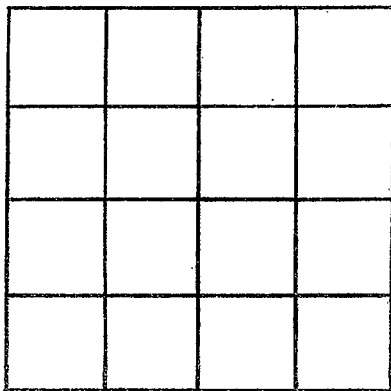

SECTION _____

Please indicate well location X.

ADDITIONAL INFORMATION

If more than one screen,
show locations of each on sketch.