

NEWTON
K 2006
3-2-77

MISSISSIPPI
 BOARD OF WATER COMMISSIONERS
 416 North State Street
 13P Jackson, Mississippi 39201

WATER WELL DRILLERS LOG

3-2-77 19 *McDonald & Will* *Newton*
 date well completed firm name county well located


LANDOWNER:	description of formations encountered	from	to
<i>Billy Earl Devine</i> <i>Post, Recatur</i> (mailing address)			
WELL LOCATION:	<i>sand</i>	<i>20</i>	<i>70</i>
sec. <i>15</i> T. <i>6</i> (N) R. <i>11</i> (E)	<i>shale st rock</i>	<i>70</i>	<i>100</i>
<i>2 1/2</i> miles <i>N</i> of <i>Newton</i> (distance) (direction) (nearest town)	<i>sandy shale</i>	<i>100</i>	<i>120</i>
WELL PURPOSE: <i>home</i> (home, irrigation, municipal, industrial)	<i>shale st sand</i>	<i>120</i>	<i>140</i>
WELL COMPLETION DATA:	<i>sandy shale</i>	<i>140</i>	<i>160</i>
(1) diameter (inches) <i>4"</i>	<i>shale st sand</i>	<i>160</i>	<i>245</i>
(2) total depth (feet) <i>480'</i>	<i>sand</i>	<i>245</i>	<i>350</i>
(3) static water level (feet) <i>175'</i> below top of ground.	<i>sandy shale</i>	<i>350</i>	<i>380</i>
(4) casing <i>PVC, 400'</i> (material) (depth)	<i>shale</i>	<i>380</i>	<i>430</i>
<i>4"</i> if telescope see back. (size)	<i>Rock + shale</i>	<i>430</i>	<i>460</i>
(5) screen (length) (depth to top)	<i>green sand</i>	<i>460</i>	<i>480</i>
(size) (material)			
(6) pump <i>3u</i> <i>5gpm</i> (HP) (yield gpm)			
<i>E</i> (type power)			
(7) electric log (yes or no)			
(organization running log)			
(8) how well bottom plugged <i>open</i>			
DRILLERS REMARKS:			

RECEIVED
 MAR 14 1977

MISS. BD. OF WATER COMMISSIONERS

If well telescopes please sketch and show depths.

GROUND LEVEL

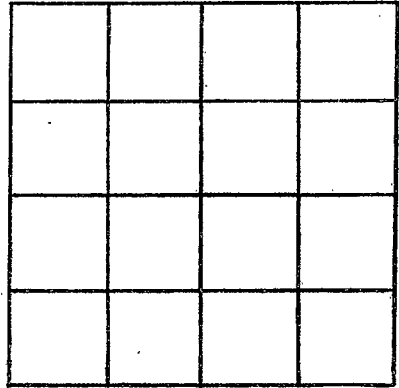

SECTION _____

Please indicate well location X.

ADDITIONAL INFORMATION

If more than one screen, show locations of each on sketch.