

Newton  
K 2007  
3-24-77

MISSISSIPPI  
 BOARD OF WATER COMMISSIONERS  
 416 North State Street  
 Jackson, Mississippi 39201

13P

WATER WELL DRILLERS LOG


3-24-77 19 McDonald & Hall Newton  
 date well completed firm name county well located

LANDOWNER:	description of formations encountered	from	to
Robert Sarwin Rt # Newton (mailing address)			
WELL LOCATION:	clay	0	10
sec. <u>31</u> T. <u>6(N)</u> R. <u>16(E)</u>	shale	10	25
<u>2</u> miles <u>west</u> of <u>Newton</u>	sand	25	100
(distance) (direction) (nearest town)	shale + lignite	100	120
WELL PURPOSE: <u>home</u>	sandy shale + Rock	120	190
(home, irrigation, municipal, industrial)	sand + shale	190	385
WELL COMPLETION DATA:	sandy shale	385	415
(1) diameter (inches) <u>4"</u>	shale	415	465
(2) total depth (feet) <u>540'</u>	Rock + shale	465	495
(3) static water level (feet) <u>100'</u> below top of ground.	green sand	495	540
(4) casing <u>PVC 432'</u>			
(material) (depth)			
<u>4"</u> If telescope see back.			
(size)			
(5) screen			
(length) (depth to top)			
(size) (material)			
(6) pump <u>1/2</u> <u>6 gpm</u>			
(HP) (yrd/d gpm)			
<u>K</u>			
(type power)			
(7) electric log			
(yes or no)			
(organization running log)			
(8) how well bottom plugged <u>open</u>			
DRILLERS REMARKS:			

RECEIVED  
 APR 4 1977  
 MISS. BO. OF WATER COMMISSIONERS

If well telescopes please  
sketch and show depths.

GROUND LEVEL

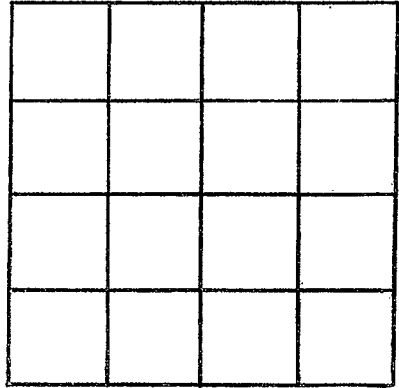

SECTION \_\_\_\_\_

Please indicate well location X.

ADDITIONAL INFORMATION

If more than one screen,  
show locations of each on sketch.