

NEWTON  
K 2008  
6-18-77

MISSISSIPPI  
 BOARD OF WATER COMMISSIONERS  
 416 North State Street  
 Jackson, Mississippi 39201

WATER WELL DRILLERS LOG

6-18-77 19 McDonald + Hill Newton  
 date well completed firm name county well located


LANDOWNER:	description of formations encountered	from	to
<u>R. F. Cochran</u> <u>Newton, Box 498</u> (mailing address)	<u>clay</u> <u>sand</u>	<u>0</u>	<u>10</u>
WELL LOCATION: sec. <u>34 T 5 N</u> R <u>11 E</u> miles _____ of <u>Newton</u> (distance) (direction) (nearest town)			
WELL PURPOSE: <u>home</u> (home, irrigation, municipal, industrial)			
WELL COMPLETION DATA:			
(1) diameter (inches) <u>2"</u>			
(2) total depth (feet) _____			
(3) static water level (feet) <u>8'</u> below above top of ground.			
(4) casing <u>PVC</u> , <u>30'</u> (material) (depth) <u>2"</u> if telescope see back. (size)			
(5) screen <u>5'</u> , <u>30' to 35'</u> (length) (depth to top) <u>2</u> <u>PVC</u> (size) (material)			
(6) pump <u>1/2</u> <u>5 g.p.m.</u> (HP) (yield gpm) <u>F</u> (type power)			
(7) electric log _____ (yes or no)			
(8) how well bottom plugged _____ (organization running log)			
DRILLERS REMARKS: <u>work</u>			

**RECEIVED**  
 JUN 28 1977

MISS. BD. OF WATER COMMISSIONERS

If well telescopes please sketch and show depths.

GROUND LEVEL

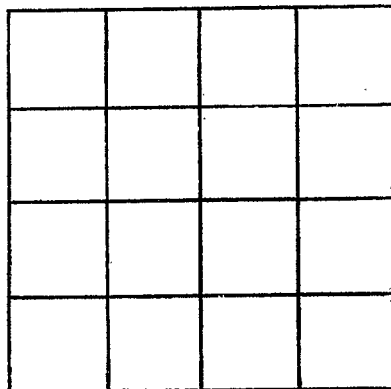

SECTION \_\_\_\_\_

Please indicate well location X.

ADDITIONAL INFORMATION

If more than one screen, show locations of each on sketch.