

Newton
K 2009
8/6/77

MISSISSIPPI
BOARD OF WATER COMMISSIONERS
416 North State Street
Jackson, Mississippi 39201

WATER WELL DRILLERS LOG

8-6-77 19 Williamson Drilling Co. Newton
date well completed firm name county well located

LANDOWNER John Mayfield
Newton Newton
Ms.
(mailing address)

description of formations encountered	from	to
red clay	0	7
blue clay	7	65
sand & clay	65	110
blue clay	110	230
trilled sand & clay	230	305
sand	305	343

WELL LOCATION:
sec 26 T-60 R 11 E
inside city limits of Newton
(distance) miles (direction) of (nearest town)

WELL PURPOSE: irrigation
(home, irrigation, municipal, industrial)

- WELL COMPLETION DATA:
- (1) diameter (inches) 4"
 - (2) total depth (feet) 343
 - (3) static water level (feet) 110 ^{below} _{above} top of ground.
 - (4) casing PVC 218
(material) (depth)
 - 4" If telescope see back.
(size)
 - (5) screen 15 328
(length) (depth to top)
 - 10 PVC
(size) (material)
 - (6) pump 1 20
(HP) (yield gpm)
 - Electric
(type power)
 - (7) electric log No
(yes or no)
 - No
(organization running log)
 - (8) how well bottom plugged Rock
Wash Valve

RECEIVED


NOV 29 1977

MISS. DE. WATER COMM.

DRILLERS REMARKS:

If well telescopes please sketch and show depths.

GROUND LEVEL

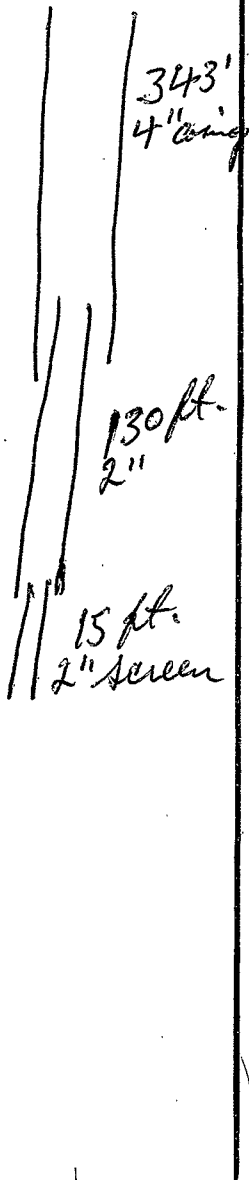

	X		

SECTION 26

Please indicate well location X.

ADDITIONAL INFORMATION

If more than one screen, show locations of each on sketch.