

**MISSISSIPPI  
BOARD OF WATER COMMISSIONERS**  
416 North State Street  
Jackson, Mississippi 39201

**WATER WELL DRILLERS LOG**

Newton  
K 2010  
8/29/77

8-29-77 19 Williamson Drilling Co. Newton  
date well completed firm name county well located

LANDOWNER: L.A. Horn  
Newton Ms.  
  
(mailing address)

description of formations encountered	from	to
<u>top soil</u>	<u>0</u>	<u>3</u>
<u>Blue Clay</u>	<u>3</u>	<u>60</u>
<u>sand &amp; clay</u>	<u>60</u>	<u>93</u>
<u>sand</u>	<u>93</u>	<u>115</u>

WELL LOCATION:  
sec. 30 T. 60 N. R. 11 E.  
S. W.  
1 miles West of Newton  
(distance) (direction) (nearest town)

WELL PURPOSE: Home  
(home, irrigation, municipal, industrial)

- WELL COMPLETION DATA:
- (1) diameter (inches) 9
  - (2) total depth (feet) 115
  - (3) static water level (feet) 90 <sup>below</sup> <sub>above</sub> top of ground.
  - (4) casing PVC 110  
(material) (depth)
  - 1 If telescope see back.  
(size)
  - (5) screen 5 115  
(length) (depth to top)
  - 16 PVC  
(size) (material)
  - (6) pump 2 HP Compressor  
(HP) (yield gpm)  
Electric  
(type power)
  - (7) electric log no  
(yes or no)  
no  
(organization running log)
  - (8) how well bottom plugged Cap

**RECEIVED**


NOV 29 1977

DRILLERS REMARKS:

MISS. BD OF WATER COM.

If well telescopes please sketch and show depths.

GROUND LEVEL

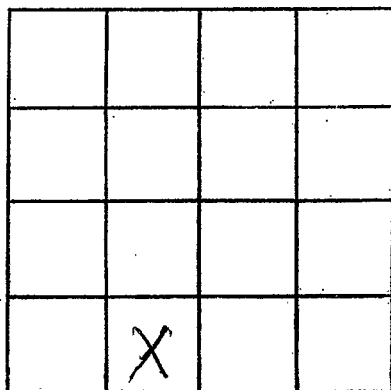

SECTION 30

Please indicate well location X.

ADDITIONAL INFORMATION

If more than one screen,  
show locations of each on sketch.